

Pipe
G 2007
5-19-76

MISSISSIPPI
BOARD OF WATER COMMISSIONERS
416 North State Street
Jackson, Mississippi 39201

WATER WELL DRILLERS LOG

19 May 1976 J. T. Courant & Son Pike
date well completed firm name county well located


| LANDOWNER: | description of formations encountered | from | to |
|--|--|------|-----|
| <u>Cland Smith</u> | | 0 | 25 |
| <u>Map.</u> (mailing address) | <u>clay</u> <u>bedded</u> <u>shale</u> <u>and</u> | 25 | 107 |
| WELL LOCATION: sec. <u>13</u> T <u>2</u> N R <u>7</u> E <u>4</u> miles <u>W</u> of <u>Map</u> (distance) (direction) (nearest town) | | | |
| WELL PURPOSE: (home, irrigation, municipal, industrial) | | | |
| WELL COMPLETION DATA: | | | |
| (1) diameter (inches) <u>4</u> | | | |
| (2) total depth (feet) <u>107</u> | | | |
| (3) static water level (feet) <u>85</u> below top of ground. | | | |
| (4) casing <u>pl</u> (<u>101</u>) (material) (depth) (size) If telescope see back. | | | |
| (5) screen <u>6</u> (<u>101</u>) (length) (depth to top) (size) (material) | | | |
| (6) pump <u>K</u> (<u>2</u>) (HP) (yield gpm) <u>Electric</u> (type power) | | | |
| (7) electric log (yes or no) | | | |
| (organization running log) | | | |
| (8) how well bottom plugged <u>wood</u> | | | |
| DRILLERS REMARKS: | | | |

RECEIVED
JUL 20 1976

MISS. BD. OF WATER COMMISSIONERS

If well telescopes please sketch and show depths.

GROUND LEVEL

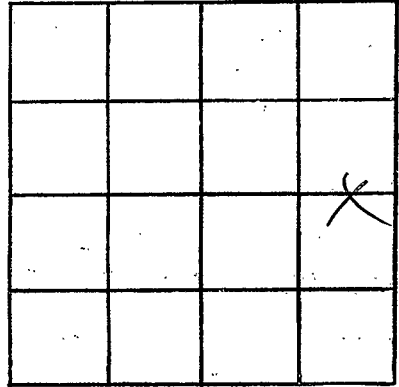

SECTION 13

Please indicate well location X.

ADDITIONAL INFORMATION

If more than one screen, show locations of each on sketch.