

Pike  
 G 2008  
 5/31/76

MISSISSIPPI  
 BOARD OF WATER COMMISSIONERS  
 416 North State Street  
 Jackson, Mississippi 39201

144

WATER WELL DRILLERS LOG

May 31 1976 Reener-Willer Pike  
 date well completed firm name county well located

LANDOWNER:  
Grady Magee  
Pt. 3 - McComb  
 (mailing address)

description of formations encountered	depth	
	from	to
<u>Red Clay</u>	<u>0</u>	<u>20</u>
<u>chalk &amp; gravel</u>	<u>20</u>	<u>42</u>
<u>pink Chalk</u>	<u>40</u>	<u>90</u>
<u>sands &amp; gravel</u>	<u>90</u>	<u>115</u>

WELL LOCATION:  
 sec. 3 T. 2 N. R. 7 E  
2 miles S-SE of Perry  
 (distance) (direction) (nearest town)

WELL PURPOSE: Trailer  
 (home, irrigation, municipal, industrial)

- WELL COMPLETION DATA:
- (1) diameter (inches) 4"
  - (2) total depth (feet) 115
  - (3) static water level (feet) 50 below top of ground.
  - (4) casing plastic bottom  
 (material) (depth)
  - (5) screen 6" 109  
 (length) (depth to top)
  - (6) pump 3/4 HP 6  
 (type power) (yield gpm)
  - (7) electric log no  
 (yes or no)
- (organization running log)

(8) how well bottom plugged:  
Wacker plug

DRILLERS REMARKS:  
no remark


RECEIVED

AUG 20 1976

MISS. BD. OF WATER COMM

If well telescopes please sketch and show depths.

GROUND LEVEL

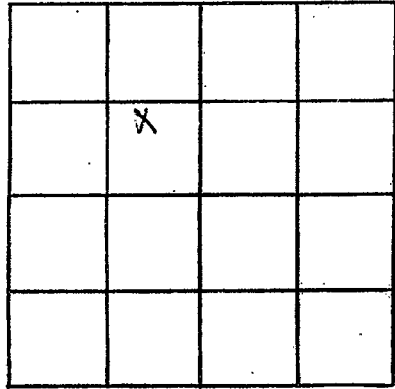

SECTION 3

Please indicate well location X.

ADDITIONAL INFORMATION

If more than one screen,  
show locations of each on sketch.