

Pike  
G 2007  
6-16-76

MISSISSIPPI  
 BOARD OF WATER COMMISSIONERS  
 416 North State Street  
 Jackson, Mississippi 39201  
 WATER WELL DRILLERS LOG

16 Jul 76 19 J. T. Cunningham Pike  
 date well completed firm name county well located

LANDOWNER: Dr. A. V. Beckham  
Magnolia  
 (mailing address)  
 WELL LOCATION:  
 sec 23 T 2 N R 7 E  
1 miles S Mag  
 (distance) (direction) (nearest town)

description of formations encountered	from	to
<u>Clay</u>	<u>0</u>	<u>15</u>
<u>Red sand</u>	<u>15</u>	<u>60</u>
<u>Chalk</u>	<u>60</u>	<u>75</u>
<u>Sand</u>	<u>75</u>	<u>196</u>

WELL PURPOSE:  
 (home, irrigation, municipal, industrial)


WELL COMPLETION DATA:  
 (1) diameter (inches) 4  
 (2) total depth (feet) 196  
 (3) static water level (feet) 6 below top of ground.  
 (4) casing PI 192  
 (material) (depth)  
 (size) if telescope see back.  
 (5) screen 24 177  
 (length) (depth to top)  
4 PI  
 (size) (material)  
 (6) pump \_\_\_\_\_ (HP) \_\_\_\_\_ (yield gpm)  
 (type power) \_\_\_\_\_  
 (7) electric log \_\_\_\_\_ (yes or no)  
 (organization running log) \_\_\_\_\_  
 (8) how well bottom plugged \_\_\_\_\_

**RECEIVED**  
 SEP - 1 1976

DRILLERS REMARKS:  
Well Flow 10-12 GPM

If well telescopes please sketch and show depths.

GROUND LEVEL

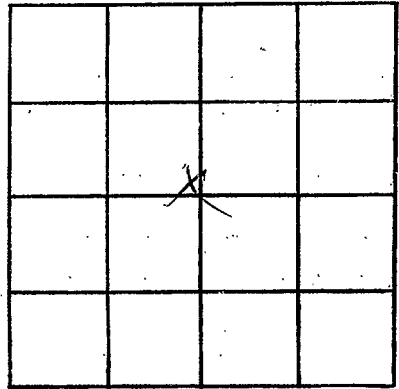

SECTION 23

Please indicate well location X.

ADDITIONAL INFORMATION

If more than one screen, show locations of each on sketch.