

Pike
G 2011
9-23-76

MISSISSIPPI
 BOARD OF WATER COMMISSIONERS
 416 North State Street
 Jackson, Mississippi 39201

WATER WELL DRILLERS LOG

Sept 23 1976 Reems Miller Pike
 date well completed firm name county well located

LANDOWNER:
Mary Patterson
Pt. Magnolia
 (mailing address)

description of formations encountered	from	to
<u>Red Clay</u>	<u>0</u>	<u>18</u>
<u>Red Chalky Sand</u>	<u>18</u>	<u>90</u>
<u>sand & gravel</u>	<u>90</u>	<u>112</u>

WELL LOCATION:
 sec. 20 T. 2 N R. 7 E
3 1/2 miles S-SW of Magnolia
 (distance) (direction) (nearest town)

WELL PURPOSE: home
 (home, irrigation, municipal, industrial)

- WELL COMPLETION DATA:
- (1) diameter (inches) 4"
 - (2) total depth (feet) 112
 - (3) static water level (feet) 85 below above top of ground.
 - (4) casing plast. bottom (material) (depth)
 - (size) if telescope see back.
 - (5) screen 6" 106 (length) (depth to top)
 - (size) (material) 4" plastic
 - (6) pump 1/2 10 (HP) (yield gpm)
 - (type power) list
 - (7) electric log no (yes or no)
 - (organization running log)

(8) how well bottom plugged
Wooder Plug

DRILLERS REMARKS:


RECEIVED

DEC 8 1976

MISS. BD. OF WATER COMMISSIONERS

If well telescopes please sketch and show depths.

GROUND LEVEL

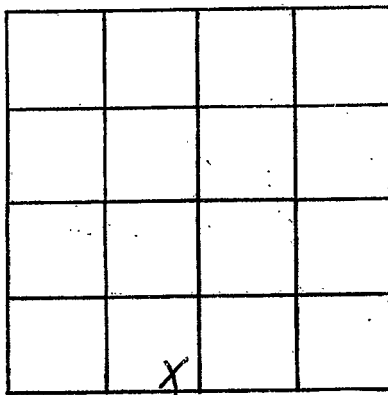

SECTION 20

Please indicate well location X.

ADDITIONAL INFORMATION

If more than one screen, show locations of each on sketch.