

Pike
 G 2012
 10/7/76

MISSISSIPPI
 BOARD OF WATER COMMISSIONERS
 416 North State Street
 Jackson, Mississippi 39201

WATER WELL DRILLERS LOG

Oct 7 1976 ^{14H} News ~~well~~ ^{Pike} ~~well~~
 date well completed firm name county well located

LANDOWNER:
 Lee Falcone
 Rt. Magnolia
 (mailing address)

description of formations encountered	from	to
	Red Clay	0
Red sand	16	40
pink Chalk	40	68
fine gravel sand	68	85

WELL LOCATION:
 sec 36 T 2 N R 7 E
 4 miles South of Magnolia
 (distance) (direction) (nearest town)

WELL PURPOSE: dairy farm
 (home, irrigation, municipal, industrial)

WELL COMPLETION DATA:

(1) diameter (inches) 4"
 (2) total depth (feet) 85
 (3) static water level (feet) 75 below top of ground.
 (4) casing 4" (material) 85 (depth)
 (size) If telescope see back.
 (5) screen 6' (length) 79 (depth to top)
 4" (size) plastic (material)
 (6) pump 1/2 HP (HP) 10 (yield gpm)
 electric (type power)
 (7) electric log NO (yes or no)
 (organization running log)

(8) how well bottom plugged
 washer plug


DRILLERS REMARKS:

RECEIVED
 DEC 8 1976

MISS. BD. OF WATER CONTROL

If well telescopes please sketch and show depths.

GROUND LEVEL

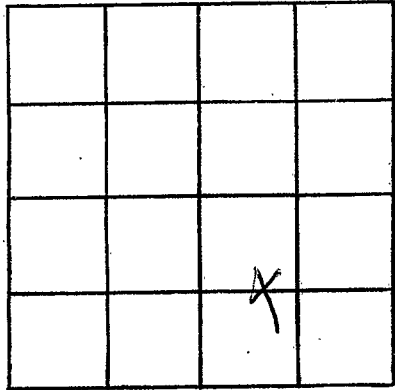

SECTION *Rb*

Please indicate well location X.

ADDITIONAL INFORMATION

If more than one screen, show locations of each on sketch.