

Pipe
 G 2013
 7-8-76

MISSISSIPPI
 BOARD OF WATER COMMISSIONERS
 416 North State Street
 Jackson, Mississippi 39201

WATER WELL DRILLERS LOG

July 8 1976 Reamer Well Serv. Pipe
 date well completed firm name county well located

LANDOWNER:
Leon Spears
Rt. Magnolia
 (mailing address)

WELL LOCATION:
 sec. 3 T 2 N R 7 E
1 miles South Perry direction (nearest town)

WELL PURPOSE: home
 (home, irrigation, municipal, industrial)

WELL COMPLETION DATA:
 (1) diameter (inches) 4"
 (2) total depth (feet) 120
 (3) static water level (feet) 60 below top of ground.
 (4) casing plastic, bottom (material) (depth)
 (size) If telescope see back.
 (5) screen 6' 114 (length) (depth to top)
4" plastic (size) (material)
 (6) pump 1/2 10 (HP) (yield gpm)
slut (type power)
 (7) electric log no (yes or no)
 (organization running log)

(8) how well bottom plugged
wooden plug

DRILLERS REMARKS:


description of formations encountered	from	to
<u>red clay</u>	<u>0</u>	<u>25</u>
<u>loose sand</u>	<u>25</u>	<u>110</u>
<u>pea gravel</u>	<u>110</u>	<u>120</u>

RECEIVED
 OCT 22 1976

MISS. RD. OF WATER COMMISSIONERS

If well telescopes please sketch and show depths.

GROUND LEVEL

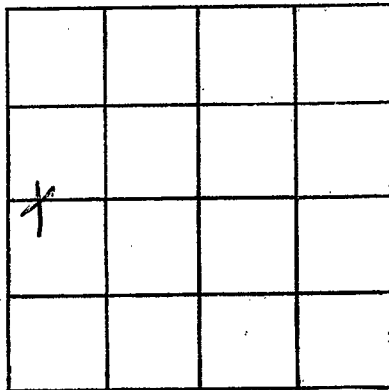

SECTION 7

Please indicate well location X.

ADDITIONAL INFORMATION

If more than one screen, show locations of each on sketch.