

Pike
 G 2014
 7-15-76

MISSISSIPPI
 BOARD OF WATER COMMISSIONERS
 416 North State Street
 Jackson, Mississippi 39201

WATER WELL DRILLERS LOG

July 15 1976 ^{14H} Beech Well for Pike
 date well completed firm name county well located

LANDOWNER:
 Miss Vitta Jones
 Rt Magnolia
 (mailing address)

description of formations encountered	from to	
Clay	0	18
Red sand	18	96
Gravelly Chert	96	112
Crane sand	112	125

WELL LOCATION:
 sec. 4 T. 2 N R. 7 E
 1 miles S SE of Percy Quinn
 (distance) (direction) (nearest town)

WELL PURPOSE: no house
 (home, irrigation, municipal, industrial)

- WELL COMPLETION DATA:
- (1) diameter (inches) 4"
 - (2) total depth (feet) 125
 - (3) static water level (feet) 90 below top of ground.
 - (4) casing plastic bottom
 (material) (depth)
 - (size) 7 if telescope see back.
 - (5) screen 6" 119'
 (length) (depth to top)
 - (size) 4" plastic
 (size) (material)
 - (6) pump 1/2 10
 (HP) (yield gpm)
 - (type power) split
 - (7) electric log no
 (yes or no)
 - (organization running log)

(8) how well bottom plugged
all sand plug

DRILLERS REMARKS:


RECEIVED

OCT 22 1976

MISS. BD. OF WATER COMMISSIONERS

If well telescopes please sketch and show depths.

GROUND LEVEL

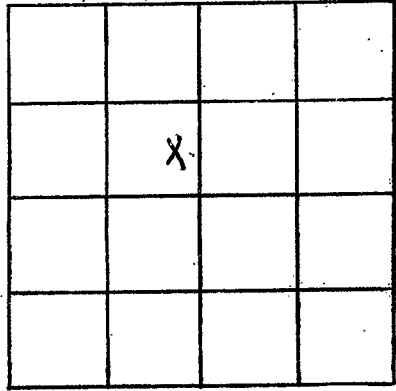

SECTION 4

Please indicate well location X.

ADDITIONAL INFORMATION

If more than one screen,
show locations of each on sketch.