

Pike
 B 2056
 8/13/77

MISSISSIPPI
 BOARD OF WATER COMMISSIONERS
 416 North State Street
 Jackson, Mississippi 39201

104

WATER WELL DRILLERS LOG

Aug 13 1977 *Recess Well Ser.* *Pike*
 date well completed firm name county well located

LANDOWNER:
J. L. Furman
Rt 1 Magnolia
 (mailing address)

description of formations encountered	from	to
<i>clay</i>	<i>0</i>	<i>12</i>
<i>fine sand</i>	<i>12</i>	<i>75</i>
<i>fine gravel sand</i>	<i>75</i>	<i>80</i>

WELL LOCATION:
 sec. *15* T *2* N R *7* E
1 1/2 miles *west* of *Magnolia*
 (distance) (direction) (nearest town)

WELL PURPOSE: *home*
 (home, irrigation, municipal, industrial)

WELL COMPLETION DATA:

(1) diameter (inches) _____

(2) total depth (feet) *80*

(3) static water level (feet) *30* below top of ground *above*

(4) casing *plastic bottom*
 (material) (depth)

_____ If telescope see back.
 (size)

(5) screen *5'* *75'*
 (length) (depth to top)

4' *plastic*
 (size) (material)

(6) pump *by other*
 (HP) (yield gpm)

list
 (type power)

(7) electric log *No*
 (yes or no)

_____ (organization running log)


(8) how well bottom plugged
wooden plug

DRILLERS REMARKS:

DECLINENT
 DEC 30 1977
 MISS. BD. OF WATER COMMISSIONERS

If well telescopes please sketch and show depths.

GROUND LEVEL

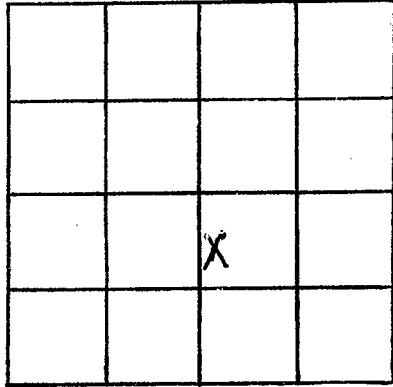

SECTION 15

Please indicate well location X.

ADDITIONAL INFORMATION

If more than one screen, show locations of each on sketch.