

PIKE  
 6 2077  
 9/30/77

MISSISSIPPI  
 BOARD OF WATER COMMISSIONERS  
 416 North State Street  
 Jackson, Mississippi 39201

134

WATER WELL DRILLERS LOG

9-30 1977 Reeves Well Co Pike  
 date well completed firm name county well located

LANDOWNER:  
~~David Kennedy~~  
 David Kennedy  
 (mailing address)  
 WELL LOCATION:  
 sec. 17 T. 2 N R. 7 E  
 3 1/2 miles West of Magnolia  
 (distance) (direction) (nearest town)

description of formations encountered	from	to
sandy clay	0	12
red sand	12	60
fine gravel & sand	60	77

WELL PURPOSE: Trailer  
 (home, irrigation, municipal, industrial)

WELL COMPLETION DATA:  
 (1) diameter (inches) 4"  
 (2) total depth (feet) 77  
 (3) static water level (feet) 38 below top of ground.  
 (4) casing plastic bottom  
 (material) (depth)  
 (size) if telescope see back.  
 (5) screen 5' 72'  
 (length) (depth to top)  
1/4" plastic  
 (size) (material)  
 (6) pump Weg other  
 (HP) (yield gpm)  
skit  
 (type power)  
 (7) electric log no  
 (yes or no)  
 (organization running log)

(8) how well bottom plugged  
Washer Plug  
 DRILLERS REMARKS:


RECEIVED

FEB 27 1978

MISS. BD. OF WATER COMM

If well telescopes please sketch and show depths.

GROUND LEVEL

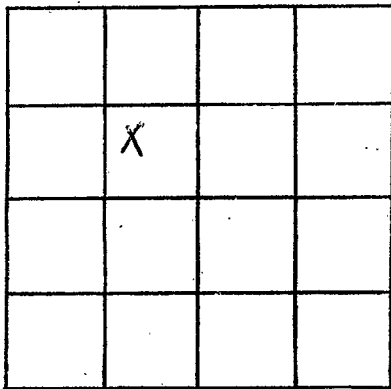

SECTION 17

Please indicate well location X.

ADDITIONAL INFORMATION

A series of horizontal lines for writing additional information, starting below the 'ADDITIONAL INFORMATION' header and extending to the bottom of the page.

If more than one screen, show locations of each on sketch.