

PIKER

G 209

5-9-78

MISSISSIPPI  
 BOARD OF WATER COMMISSIONERS  
 416 North State Street  
 Jackson, Mississippi 39201

WATER WELL DRILLERS LOG

May 9 1978 News Well Co Pike  
 date well completed firm name county well located


LANDOWNER:	description of formations encountered	from	to
<u>Martha Thompson</u> <u>At Magnolia</u> (mailing address)	<u>Red Clay</u> <u>Red sand</u> <u>sand &amp; gravel</u>	<u>0</u>	<u>14</u> <u>88</u> <u>100</u>
<b>WELL LOCATION:</b>			
sec. <u>17</u> T. <u>2</u> N R. <u>7</u> E			
<u>3</u> miles <u>west</u> of <u>Magnolia</u>			
(distance) (direction) (nearest town)			
<b>WELL PURPOSE:</b> <u>Home</u> (home, irrigation, municipal, industrial)			
<b>WELL COMPLETION DATA:</b>			
(1) diameter (inches) <u>4"</u>			
(2) total depth (feet) <u>100</u>			
(3) static water level (feet) <u>65</u> below above top of ground.			
(4) casing <u>plastic bottom</u> (material) (depth)			
_____ if telescope see back. (size)			
(5) screen <u>5'</u> <u>5'</u> (length) (depth to top)			
<u>4"</u> <u>plastic</u> (size) (material)			
(6) pump <u>1/2</u> <u>10</u> (HP) (yield gpm)			
<u>split</u> (type power)			
(7) electric log <u>no</u> (yes or no)			
_____ (organization running log)			
(8) how well bottom plugged <u>wooden plug</u>			
DRILLERS REMARKS: <u></u>			

**RECEIVED**  
 JUN 26 1978

MISS. BD. OF WATER COMMISSIONERS

If well telescopes please sketch and show depths.

GROUND LEVEL

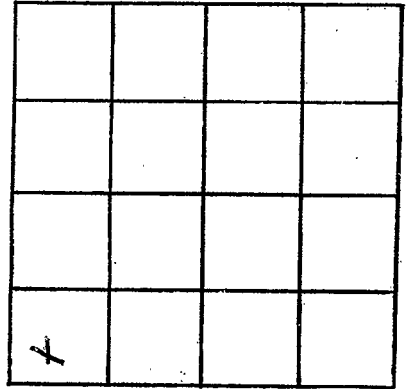

SECTION 12

Please indicate well location X.

ADDITIONAL INFORMATION

If more than one screen,  
show locations of each on sketch.