

PIKE
2020 ^G
7020-78

**MISSISSIPPI
BOARD OF WATER COMMISSIONERS**
416 North State Street
Jackson, Mississippi 39201

WATER WELL DRILLERS LOG

July 20 1978 Rever Miller Pike
 date well completed firm name county well located

LANDOWNER:
Servey Gallagher
 Rt Magnolia
 (mailing address)

description of formations encountered	from	to
<u>Red Clay</u>	<u>0</u>	<u>23</u>
<u>Red Sand</u>	<u>23</u>	<u>70</u>
<u>Sand & gravel</u>	<u>70</u>	<u>87</u>
<u>pink Chalk</u>	<u>87</u>	<u>110</u>
<u>gravel sand</u>	<u>110</u>	<u>123</u>

WELL LOCATION:
 sec. 20 T. 2 N. R. 7 E.
5 miles N. SW of Magnolia
 (distance) (direction) (nearest town)

WELL PURPOSE: home
 (home, irrigation, municipal, industrial)

- WELL COMPLETION DATA:**
- (1) diameter (inches) 4"
 - (2) total depth (feet) 123'
 - (3) static water level (feet) 95 below above top of ground.
 - (4) casing plastic bottom
 (material) (depth)
 - 5' If telescope see back.
 (size)
 - (5) screen 5' 118
 (length) (depth to top)
 - 4" plastic
 (size) (material)
 - (6) pump 1/2 hp 10
 (HP) (yield gpm)
 - electric
 (type power)
 - (7) electric log no
 (yes or no)
 - (organization running log)

(8) how well bottom plugged
water plug


DRILLERS REMARKS:
[Signature]

RECEIVED
 NOV - 7 1978

MISS. BD. OF WATER COMMISSIONERS

If well telescopes please sketch and show depths.

GROUND LEVEL

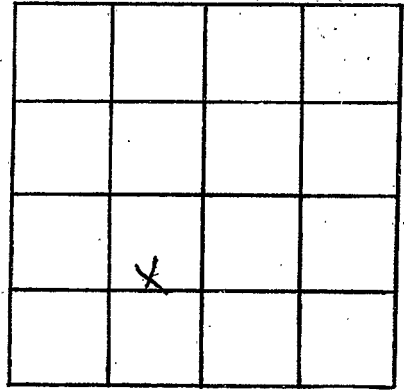

SECTION 20

Please indicate well location X.

ADDITIONAL INFORMATION

If more than one screen,
show locations of each on sketch.