

PIKE
G 2021
12-14-78

**MISSISSIPPI  
BOARD OF WATER COMMISSIONERS**  
416 North State Street  
Jackson, Mississippi 39201

**WATER WELL DRILLERS LOG**

12-14 1978 Fitzgerald Well Service Pike  
 date well completed firm name county well located


LANDOWNER:	description of formations encountered	from	to
<u>Allen Dagggett</u> <u>R.R. Magnolia</u> (mailing address)	<u>Red clay</u> <u>Red sand</u> <u>Coarse sand &amp; pea gravel</u>	<u>0</u> <u>20</u> <u>95</u>	<u>20</u> <u>95</u> <u>112</u>
<b>WELL LOCATION:</b> sec. <u>36</u> T <u>2</u> N R <u>7</u> E S W <u>5</u> miles <u>SSW</u> of <u>Magnolia</u> (distance) (direction) (nearest town)			
<b>WELL PURPOSE:</b> <u>Home</u> (home, irrigation, municipal, industrial)			
<b>WELL COMPLETION DATA:</b> (1) diameter (inches) <u>4</u> (2) total depth (feet) <u>112</u> (3) static water level (feet) <u>70</u> below/above top of ground. (4) casing <u>PVC</u> , <u>104</u> ; (material) (depth) <u>4</u> If telescope see back. (size) (5) screen <u>8</u> , <u>104</u> (length) (depth to top) <u>4</u> , <u>PVC</u> (size) (material) (6) pump <u>1/2</u> , <u>10</u> (HP) (yield gpm) <u>elec</u> (type power) (7) electric log <u>No</u> (yes or no) (organization running log) (8) how well bottom plugged <u>Sand Seal</u>			
<b>DRILLERS REMARKS:</b>			

**RECEIVED**

JAN 26 1978

If well telescopes please sketch and show depths.

GROUND LEVEL

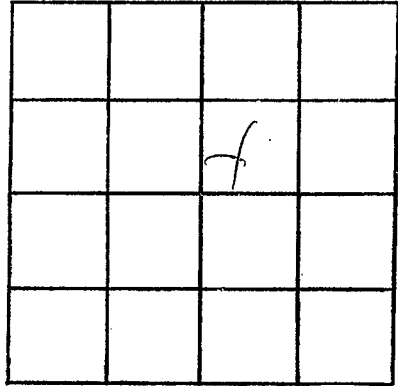

SECTION 36

Please indicate well location X.

ADDITIONAL INFORMATION

If more than one screen,  
show locations of each on sketch.