

PIKE
G <i>2022</i>
10-02-78

**MISSISSIPPI  
BOARD OF WATER COMMISSIONERS**  
416 North State Street  
Jackson, Mississippi 39201

**WATER WELL DRILLERS LOG**

Oct 2 1978 *Pearce Well Ser.* *Pike*  
 date well completed firm name county well located

**LANDOWNER:**  
*Willie Bramfield*  
*At Magnolia*  
 (mailing address)

description of formations encountered	depth	
	from	to
<i>Sandy Clay</i>	<i>0</i>	<i>22</i>
<i>Red sand</i>	<i>22</i>	<i>35</i>
<i>Gravelly</i>	<i>55</i>	<i>90</i>
<i>Coarse sand</i>	<i>90</i>	<i>108</i>

**WELL LOCATION:**  
 sec. *18* T *2* N R *7* E  
*5* miles *west* of *Magnolia*  
 (distance) (direction) (nearest town)

**WELL PURPOSE:** *home*  
 (home, irrigation, municipal, industrial)

**WELL COMPLETION DATA:**

(1) diameter (inches) *4"*

(2) total depth (feet) *108*

(3) static water level (feet) *78* below above top of ground.

(4) casing *plastic, galvanized*  
 (material) (depth)

if telescope see back.  
 (size)

(5) screen *5"* *103'*  
 (length) (depth to top)

*4"* *plastic*  
 (size) (material)

(6) pump *3/4 hp* *10*  
 (HP) (yield gpm)

*slit*  
 (type power)

(7) electric log *no*  
 (yes or no)

(organization running log)

(8) how well bottom plugged  
*bladder plug*

**DRILLERS REMARKS:**


Miss. Board of Water Comm.

FEB 15 1979

**RECEIVED**

If well telescopes please sketch and show depths.

GROUND LEVEL

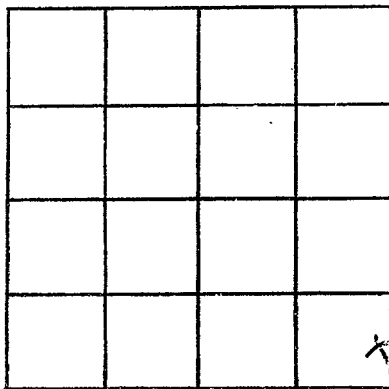

SECTION 18

Please indicate well location X.

ADDITIONAL INFORMATION

If more than one screen,  
show locations of each on sketch.