

Pike
 G 2000
 5-8-79

MISSISSIPPI
 BOARD OF WATER COMMISSIONERS
 416 North State Street
 Jackson, Mississippi 39201

WATER WELL DRILLERS LOG

May 8 1979 Remus Well Co Pike
 date well completed firm name county well located

LANDOWNER:
Julius Ziegler
Rt. Magnolia
 (mailing address)

WELL LOCATION:
 sec 30 T 2 N R 7 E
5 1/2 miles W.S.W. of Magnolia
 (distance) (direction) (nearest town)

WELL PURPOSE: Leather
 (home, irrigation, municipal, industrial)

WELL COMPLETION DATA:
 (1) diameter (inches) 4"
 (2) total depth (feet) 120
 (3) static water level (feet) 80 below above top of ground.
 (4) casing plastic bottom (material) (depth)
 (size) if telescope see back.
 (5) screen 5" 115 (length) (depth to top)
4" plastic (size) (material)
 (6) pump 3/4 12 (HP) (yield gpm)
elect (type power)
 (7) electric log no (yes or no)
 (organization running log)


(8) how well bottom plugged
wooden plug
 DRILLERS REMARKS:

description of formations encountered	from	to
clay	0	12
Red sand	12	50
pink Chalk	50	55
mid. sand Chalk	55	90
shaly	90	110
coarse sand	110	120

DEPT. OF NATURAL RESOURCES
 BUREAU OF LAND & WATER RESOURCES
 OCT 18 1979
 RECEIVED

If well telescopes please sketch and show depths.

GROUND LEVEL

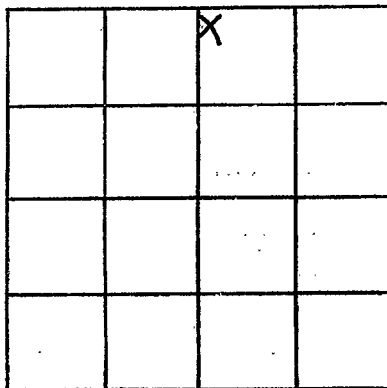

SECTION 30

Please indicate well location X.

ADDITIONAL INFORMATION

If more than one screen, show locations of each on sketch.