

Pike
G
2004
9-26-79

MISSISSIPPI
BOARD OF WATER COMMISSIONERS
416 North State Street
Jackson, Mississippi 39201

WATER WELL DRILLERS LOG

9-26 1979 79 Fitzgerald Well Drillers Inc. Pike
date well completed firm name county well located

LANDOWNER:
Lorus Lane Cafe
P.R. Magnolia
(mailing address)

description of formations encountered	from	to
Red clay	0	20
Red sand & gravel	20	100
Coarse sand & gravel	100	115

WELL LOCATION:
sec. 2 T. 20 N. R. 2 E
S W
1 miles NNW of Magnolia
(distance) (direction) (nearest town)

WELL PURPOSE:
Home
(home, irrigation, municipal, industrial)

- WELL COMPLETION DATA:
- (1) diameter (inches) 4
 - (2) total depth (feet) 115
 - (3) static water level (feet) 80 below top of ground
 - (4) casing PVC, 107, (material) (depth)
4 (size) If telescope see back.
 - (5) screen 8, 107 (length) (depth to top)
4 (size) PVC (material)
 - (6) pump 1/2, 20 (HP) (yield gpm)
ch (type power)
 - (7) electric log No (yes or no)
(organization running log)
 - (8) how well bottom plugged Sand filter

DEPT. OF NATURAL RESOURCES
BUREAU OF LAND & WATER RESOURCES


NOV - 7 1979

RECEIVED

DRILLERS REMARKS:

If well telescopes please sketch and show depths.

GROUND LEVEL

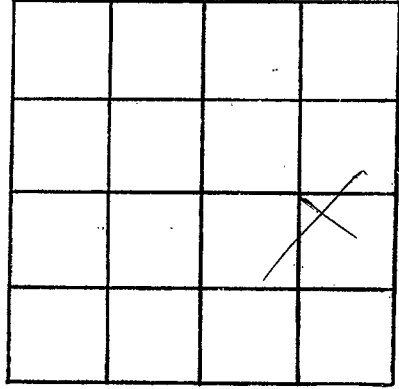

SECTION 2

Please indicate well location X.

ADDITIONAL INFORMATION

If more than one screen, show locations of each on sketch.