

DIKE
 G 2025
 5-5-80

MISSISSIPPI
 BOARD OF WATER COMMISSIONERS
 416 North State Street
 Jackson, Mississippi 39201

WATER WELL DRILLERS LOG

date well completed May 5 1980 firm name Reems Well Dr county well located Pike

LANDOWNER:
Jessie Harness
Rt. Magnolia
 (mailing address)

description of formations encountered	from	to
Clay	0	12
Red sand	12	55
pink chalk	55	70
Red sandy	70	95
loosely		
sand & gravel	95	110

WELL LOCATION:
 sec. 20 T. 2 N R. 7 E
3 1/2 miles WSW of Magnolia
 (distance) (direction) (nearest town)

WELL PURPOSE: home
 (home, irrigation, municipal, industrial)

- WELL COMPLETION DATA:
- (1) diameter (inches) 4"
 - (2) total depth (feet) 110'
 - (3) static water level (feet) 75' Below above top of ground.
 - (4) casing plastic baton
 (material) (depth)
 (size) if telescope see back.
 - (5) screen 5' 105'
 (length) (depth to top)
4" plastic
 (size) (material)
 - (6) pump by other
 (HP) (yield gpm)
elect
 (type power)
 - (7) electric log no
 (yes or no)
- (organization running log)

(8) how well bottom plugged back wash valve

DRILLERS REMARKS:


DEPT. OF NATURAL RESOURCES
 BUREAU OF LAND & WATER RESOURCES

FEB 2 - 1981

RECEIVED

If well telescopes please sketch and show depths.

GROUND LEVEL

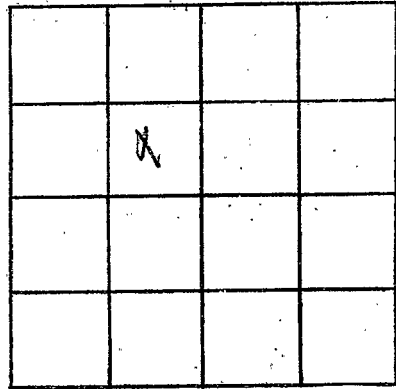

SECTION 20

Please indicate well location X.

ADDITIONAL INFORMATION

If more than one screen,
show locations of each on sketch.