

PIKE

G 2027

12-23-80

12-28

date well completed

1980

Fitzwallr Well Service

firm name

Pike

county well located

MISSISSIPPI
 BOARD OF WATER COMMISSIONERS
 416 North State Street
 Jackson, Mississippi 39201

WATER WELL DRILLERS LOG

LANDOWNER:

Unity Church

P.O. Magnolia
(mailing address)

description of formations encountered

from

to

Red clay

0

20

Red sand
Coarse sand

20

85

85

95

WELL LOCATION:

sec. 19 T. 2 N. R. 7 E.
S W

5 miles SW of Magnolia
(distance) (direction) (nearest town)

WELL PURPOSE:

Home
(home, irrigation, municipal, industrial)

WELL COMPLETION DATA:

- (1) diameter (inches) 4
- (2) total depth (feet) 95
- (3) static water level (feet) 50 below top of ground.
- (4) casing PVC, 87 (material), (depth)
4 (size) if telescope see back.
- (5) screen 8, 87 (length), (depth to top)
4 (size), PVC (material)
- (6) pump 1/2 (HP), 10 (yield gpm)
elec (type power)
- (7) electric log no (yes or no)
(organization running log)
- (8) how well bottom plugged Sand fill

DRILLERS REMARKS:


DEPT. OF NATURAL RESOURCES
BUREAU OF LAND & WATER RESOURCES

JAN 29 1981

RECEIVED

If well telescopes please sketch and show depths.

GROUND LEVEL

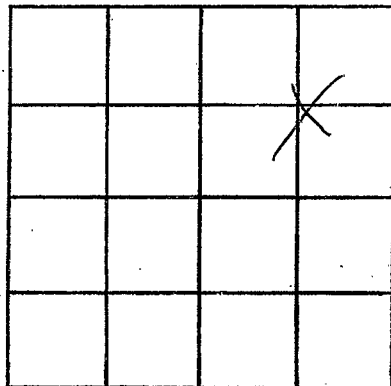

SECTION 19

Please indicate well location X.

ADDITIONAL INFORMATION

If more than one screen,
show locations of each on sketch.