

PEKE

G 2030

1-16-81

1-16

date well completed

MISSISSIPPI
 BOARD OF WATER COMMISSIONERS
 416 North State Street
 Jackson, Mississippi 39201

WATER WELL DRILLERS LOG

19 81 Fitzgerald Well Lw Peke

firm name

county well located

LANDOWNER:	description of formations encountered	from	to
Edward Rayborn			
R.R. Marmola (mailing address)	Red Clay Red Sand Coarse Sand & gravel	0 20 175	20 175 188
WELL LOCATION:			
sec. 30 T. 2 N R. 7 E S W			
6 miles W of Magnolia (distance) (direction) (nearest town)			
WELL PURPOSE: Home (home, irrigation, municipal, industrial)			
WELL COMPLETION DATA:			
(1) diameter (inches) 4			
(2) total depth (feet) 188			
(3) static water level (feet) 85 below top of ground.			
(4) casing PVC, 180, 4 (material) (depth) (size) if telescope see back.			
(5) screen 8, 180, 4, PVC (length) (depth to top) (size) (material)			
(6) pump 1, 18, Elva (HP) (yield gpm) (type power)			
(7) electric log No (yes or no) (organization running log)			
(8) how well bottom plugged L.H.H.			
DRILLERS REMARKS:			


DEPT. OF NATURAL RESOURCES
 BUREAU OF LAND & WATER RESOURCES

JAN 27 1981

RECEIVED

If well telescopes please sketch and show depths.

GROUND LEVEL

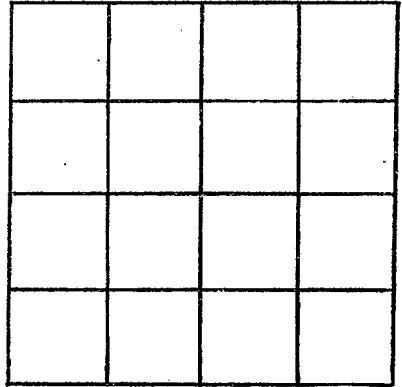

SECTION _____

Please indicate well location X.

ADDITIONAL INFORMATION

If more than one screen,
show locations of each on sketch.