

MISSISSIPPI DEPARTMENT OF NATURAL RESOURCES

Bureau of Land and Water Resources

Southport Mall

P.O. Box 10631

Jackson, Mississippi 39209

WATER WELL DRILLERS LOG

PIKE
G
2034

4-5 19 83 Hessell Well Service Deale
 date well completed firm name county well located

LANDOWNER: Mar Clayton
R.R. Magnolia Dr.
 (mailing address)

description of formations encountered	from	to
<u>Red Clay</u>	<u>0</u>	<u>20</u>
<u>Red chert</u>	<u>20</u>	<u>80</u>
<u>White chert</u>	<u>80</u>	<u>180</u>
<u>Coarse sandstone</u>	<u>180</u>	<u>165</u>

WELL LOCATION:
 sec. 4 T. 2 N. R. 7 E.
 S. W.
5 miles SSW of Magnolia
 (distance) (direction) (nearest town)

WELL PURPOSE: Home
 (home, irrigation, municipal, industrial)

- WELL COMPLETION DATA:
- (1) diameter (inches) 4
 - (2) total depth (feet) 165
 - (3) static water level (feet) 25 below above top of ground.
 - (4) casing PVC, 157,
 (material) (depth)
4 If telescope see back.
 (size)
 - (5) screen 8, 157
 (length) (depth to top)
4, PVC
 (size) (material)
 - (6) pump 1/2 10
 (HP) (yield gpm)
elc
 (type power)
 - (7) electric log no
 (yes or no)
 - (8) how well bottom plugged Lead shot
 (organization running log)

DEPT. OF NATURAL RESOURCES
 BUREAU OF LAND & WATER RESOURCES


MAY 9 - 1983

RECEIVED

DRILLERS REMARKS:

If well telescopes please sketch and show depths.

GROUND LEVEL

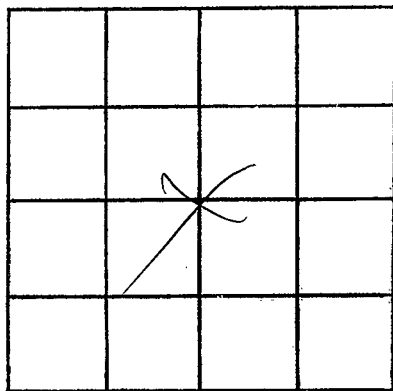

SECTION 4

Please indicate well location X.

ADDITIONAL INFORMATION

If more than one screen,
show locations of each on sketch.