

MISSISSIPPI DEPARTMENT OF NATURAL RESOURCES

Bureau of Land and Water Resources

Southport Mall

P.O. Box 10631

Jackson, Mississippi 39209

WATER WELL DRILLERS LOG

PIKE
G 2035

May 28 1983 *Russ Miller* Pike
 date well completed firm name county well located

LANDOWNER:
Colin Stetzner
At Magnolia
 (mailing address)

description of formations encountered	from to	
	ft	ft
<i>Clay</i>	<i>0</i>	<i>12</i>
<i>broken sand</i>	<i>12</i>	<i>45</i>
<i>gravel to sand</i>	<i>45</i>	<i>80</i>

WELL LOCATION:
 sec. *14* T. *2* N. R. *7* E
1/2 miles *South* of *Magnolia*
 (distance) (direction) (nearest town)

WELL PURPOSE: *Home*
 (home, irrigation, municipal, industrial)

- WELL COMPLETION DATA:
- (1) diameter (inches) *4"*
 - (2) total depth (feet) *80'*
 - (3) static water level (feet) *20* below above top of ground.
 - (4) casing *plastic, galton*
 (material) (depth)
 (size) If telescope see back.
 - (5) screen *5'* *75'*
 (length) (depth to top)
4" *plastic*
 (size) (material)
 - (6) pump *egather*
 (HP) (yield gpm)
Electric
 (type power)
 - (7) electric log *no*
 (yes or no)
 (organization running log)

(8) how well bottom plugged
back well

DRILLERS REMARKS:
None


DEPT. OF NATURAL RESOURCES
 BUREAU OF LAND & WATER RESOURCES

SEP 28 1983

RECEIVED

If well telescopes please sketch and show depths.

GROUND LEVEL

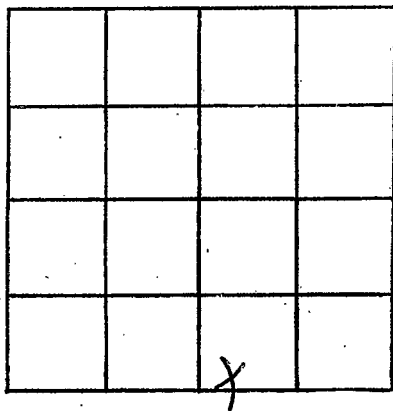

SECTION 14

Please indicate well location X.

ADDITIONAL INFORMATION

If more than one screen, show locations of each on sketch.