

MISSISSIPPI DEPARTMENT OF NATURAL RESOURCES

Bureau of Land and Water Resources

Southport Mall

P.O. Box 10631

Jackson, Mississippi 39209

WATER WELL DRILLERS LOG

PIKE
G 2030

June 27 1983 Pearce Miller Pike
date well completed firm name county well located

LANDOWNER:
S. L. Little
Magalia
(mailing address)

description of formations encountered	from	to
<u>Sandy Clay</u>	<u>0</u>	<u>16</u>
<u>Sandy Gravel</u>	<u>16</u>	<u>45</u>
<u>clay</u>	<u>45</u>	<u>60</u>
<u>sand & gravel</u>	<u>60</u>	<u>84</u>

WELL LOCATION:
sec. 11 T 2 N R 7 E
1/4 miles West of Magalia
(distance) (direction) (nearest town)

WELL PURPOSE: Tap water
(home, irrigation, municipal, industrial)

WELL COMPLETION DATA:
(1) diameter (inches) 4"
(2) total depth (feet) 84'
(3) static water level (feet) 30 below/above top of ground.
(4) casing plastic bottom (material) (depth)
_____ if telescope see back. (size)
(5) screen 10' 74" (length) (depth to top)
4" plastic (size) (material)
(6) pump 1/2 hp 19 (HP) (yield gpm)
elect (type power)
(7) electric log no (yes or no)
_____ (organization running log)

(8) how well bottom plugged back wash

DRILLERS REMARKS: _____


DEPT. OF NATURAL RESOURCES
BUREAU OF LAND & WATER RESOURCES

NOV - 9 1983

RECEIVED

If well telescopes please sketch and show depths.

GROUND LEVEL

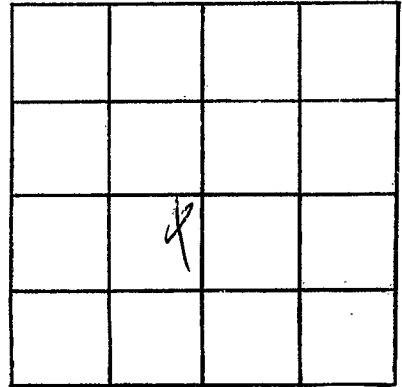

SECTION 11

Please indicate well location X.

ADDITIONAL INFORMATION

If more than one screen,
show locations of each on sketch.