

MISSISSIPPI DEPARTMENT OF NATURAL RESOURCES

Bureau of Land and Water Resources

Southport Mall

P.O. Box 10631

Jackson, Mississippi 39209

WATER WELL DRILLERS LOG

PIKE
G 2037

July 16 1983 *Russell Miller Pike*
date well completed firm name county well located

LANDOWNER:	description of formations encountered	from	to
H. W. Cutler At Magnolia (mailing address)			
WELL LOCATION:			
sec. 17 T 2 N R 7 E 4 miles West of Magnolia (distance) (direction) (nearest town)			
WELL PURPOSE: <i>Camp</i> (home, irrigation, municipal, industrial)			
WELL COMPLETION DATA:			
(1) diameter (inches) <i>4"</i>			
(2) total depth (feet) <i>115</i>			
(3) static water level (feet) <i>level</i> below/above top of ground.			
(4) casing <i>plastic bottom</i> (material) (depth)			
(size) If telescope see back.			
(5) screen <i>5'</i> / <i>110</i> (length) (depth to top)			
<i>4"</i> / <i>plastic</i> (size) (material)			
(6) pump <i>pop pump</i> / <i>6</i> (HP) (yield gpm)			
<i>1000</i> (type power)			
(7) electric log <i>no</i> (yes or no)			
(organization running log)			
(8) how well bottom plugged <i>back wash</i>			
DRILLERS REMARKS:			


DEPT. OF NATURAL RESOURCES
BUREAU OF LAND & WATER RESOURCES

NOV - 3 1983

RECEIVED

If well telescopes please sketch and show depths.

GROUND LEVEL

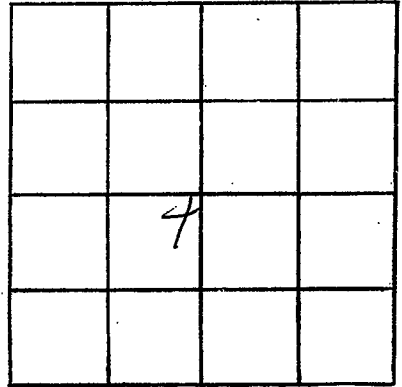

SECTION F7

Please indicate well location X.

ADDITIONAL INFORMATION

If more than one screen,
show locations of each on sketch.