

MISSISSIPPI DEPARTMENT OF NATURAL RESOURCES

Bureau of Land and Water Resources

Southport Mall

P.O. Box 10631

Jackson, Mississippi 39209

WATER WELL DRILLERS LOG

PIKE
G 2038

11-10
date well completed

1983 Ft Gould
firm name

Perla
county well located

LANDOWNER:	description of formations encountered	from	to
John Wayne Simmons RR, 2000 ... (mailing address)			
WELL LOCATION:			
sec. 24 T-2N R-7E S W			
2 miles SE of Magnolia (distance) (direction) (nearest town)			
WELL PURPOSE: (home, irrigation, municipal, industrial)			
WELL COMPLETION DATA:			
(1) diameter (inches) 4			
(2) total depth (feet) 130			
(3) static water level (feet) 85 below top of ground.			
(4) casing PVC, 122, (depth) 4 (size) if telescope see back.			
(5) screen 8, 122 (length) (depth to top) 4 (size), PVC (material)			
(6) pump 1/2 (HP) 10 (yield gpm) elec (type power)			
(7) electric log no (yes or no) (organization running log)			
(8) how well bottom plugged			
DRILLERS REMARKS:			


DEPT. OF NATURAL RESOURCES
BUREAU OF LAND & WATER RESOURCES

DEC - 9 1983

RECEIVED

If well telescopes please sketch and show depths.

GROUND LEVEL

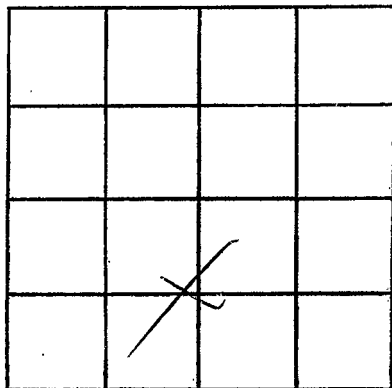

SECTION 24

Please indicate well location X.

ADDITIONAL INFORMATION

If more than one screen,
show locations of each on sketch.