

PIKE
G 3031

MISSISSIPPI DEPARTMENT OF NATURAL RESOURCES
 Bureau of Land and Water Resources
 Southport Mall
 P.O. Box 10631
 Jackson, Mississippi 39209
WATER WELL DRILLERS LOG

Sept 28 1983 Runes Well Service Pike
 date well completed firm name county well located

LANDOWNER:
Richard Garner
Chattahoochee Camp
 (mailing address)

description of formations encountered	depth	
	from	to
<u>Gravel & sand</u>	<u>0</u>	<u>22</u>
<u>sand</u>	<u>22</u>	<u>50</u>
<u>Sand Rock</u>	<u>50</u>	<u>54</u>
<u>yellow & brown sand</u>	<u>54</u>	<u>100</u>
<u>White Chalk</u>	<u>100</u>	<u>120</u>
<u>Coarse sand</u>	<u>120</u>	<u>143</u>


WELL LOCATION:
 sec. 35 T 2 N R 7 E
2 1/2 miles north of Chattahoochee
 (distance) (direction) (nearest town)

WELL PURPOSE: Camp
 (home, irrigation, municipal, industrial)

WELL COMPLETION DATA:
 (1) diameter (inches) 4 1/2"
 (2) total depth (feet) 143
 (3) static water level (feet) 60 below/above top of ground.
 (4) casing plastic 60' (material) (depth)
 (size) If telescope see back.
 (5) screen 5' 138' (length) (depth to top)
4" (size) plastic (material)
 (6) pump 1/2 10 (HP) (yield gpm)
115v (type power)
 (7) electric log no (yes or no)
 (organization running log)


(8) how well bottom plugged
back wash

DRILLERS REMARKS:

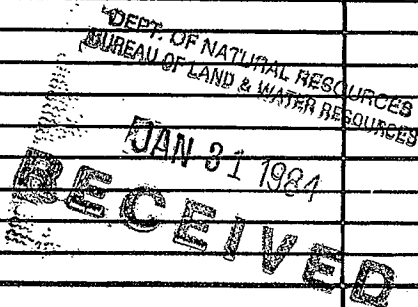

If well telescopes please sketch and show depths.

GROUND LEVEL

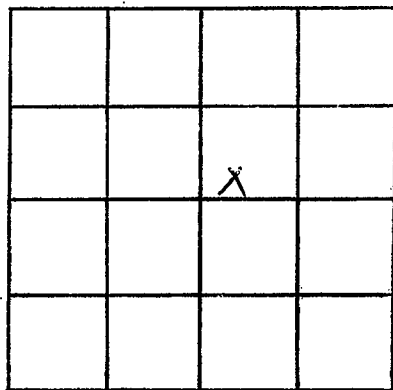

SECTION 35

Please indicate well location X.

ADDITIONAL INFORMATION

If more than one screen, show locations of each on sketch.