

MISSISSIPPI DEPARTMENT OF NATURAL RESOURCES

Bureau of Land and Water Resources

Southport Mall

P.O. Box 10631

Jackson, Mississippi 39209

WATER WELL DRILLERS LOG

<i>Pike</i>
<i>G G</i>
<i>2040</i>

2-13 1984
date well completed

Fitzgerald well Serv
firm name

Pike
county well located

LANDOWNER:
Jane Jay
RR- Magnolia, Ms.
(mailing address)

description of formations encountered	from	to
<i>Red clay</i>	<i>0</i>	<i>20</i>
<i>Red gravel</i>	<i>20</i>	<i>90</i>
<i>Coarse sand & gravel</i>	<i>90</i>	<i>100</i>

WELL LOCATION:
sec. *13* T *2* N R *2* E
 S W
1/2 miles *SE* of *Magnolia*
(distance) (direction) (nearest town)

WELL PURPOSE: *Home*
(home, irrigation, municipal, industrial)

WELL COMPLETION DATA:

(1) diameter (inches) *4*

(2) total depth (feet) *100*

(3) static water level (feet) *32* below
top of ground.

(4) casing *PVC*, *92*,
(material) (depth)
4 if telescope see back.
(size)

(5) screen *8*, *92*
(length) (depth to top)
4, *PVC*
(size) (material)

(6) pump *1/2*, *10*
(HP) (yield gpm)
Elc
(type power)

(7) electric log *no*
(yes or no)
(organization running log)

(8) how well bottom plugged *Sealed*

DEPT. OF NATURAL RESOURCES
BUREAU OF LAND & WATER RESOURCES


MAR -7 1984

RECEIVED

DRILLERS REMARKS:

If well telescopes please
sketch and show depths.

GROUND LEVEL

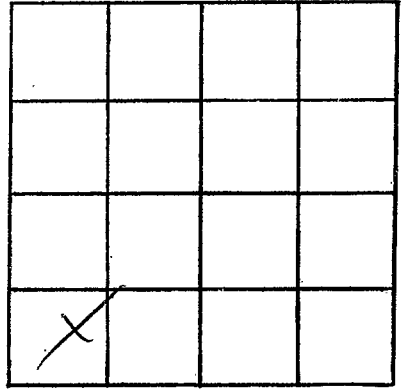

SECTION 13

Please indicate well location X.

ADDITIONAL INFORMATION

If more than one screen,
show locations of each on sketch.