

MISSISSIPPI DEPARTMENT OF NATURAL RESOURCES

Bureau of Land and Water Resources

Southport Mall

P.O. Box 10631

Jackson, Mississippi 39209

WATER WELL DRILLERS LOG

PIKE  
G 2042

10-2  
date well completed

1984 F. Goodrich Serv  
firm name

Pike  
county well located

LANDOWNER:	description of formations encountered	from	to
<u>Paul Stealing</u>			
<u>R.R. Magnolia Ms.</u> (mailing address)	<u>Red clay</u>	<u>0</u>	<u>20</u>
	<u>Red sand</u>	<u>20</u>	<u>70</u>
	<u>Coarse sand &amp; gravel</u>	<u>70</u>	<u>120</u>
WELL LOCATION: sec. <u>4</u> T. <u>2</u> N. R. <u>7</u> E S W <u>1</u> miles <u>S</u> of <u>Pocahontas</u> (distance) (direction) (nearest town)			
WELL PURPOSE: <u>Home</u> (home, irrigation, municipal, industrial)			
WELL COMPLETION DATA:			
(1) diameter (inches) <u>4</u>			
(2) total depth (feet) <u>120</u>			
(3) static water level (feet) <u>70</u> below top of ground.			
(4) casing <u>pvc</u> , <u>112</u> , (material) (depth)			
<u>4</u> if telescope see back. (size)			
(5) screen <u>8</u> , <u>112</u> (length) (depth to top)			
<u>4</u> , <u>pvc</u> (size) (material)			
(6) pump <u>1/2</u> , <u>10</u> (HP) (yield gpm)			
<u>elm</u> (type power)			
(7) electric log <u>no</u> (yes or no)			
(organization running log)			
(8) how well bottom plugged <u>Sand fill</u>			
DRILLERS REMARKS:			


DEPT. OF NATURAL RESOURCES  
BUREAU OF LAND & WATER RESOURCES

DEC - 4 1984

RECEIVED

If well telescopes please sketch and show depths.

GROUND LEVEL

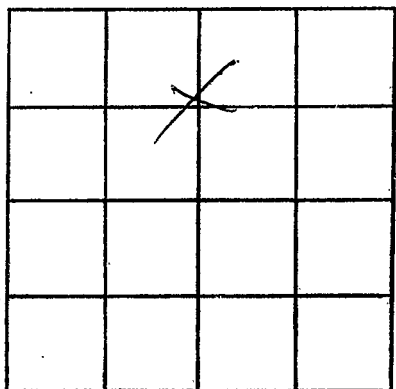

SECTION 4

Please indicate well location X.

ADDITIONAL INFORMATION

If more than one screen,  
show locations of each on sketch.