

MISSISSIPPI DEPARTMENT OF NATURAL RESOURCES
 Bureau of Land and Water Resources
 Southport Mall
 P.O. Box 10631
 Jackson, Mississippi 39209
WATER WELL DRILLERS LOG


Pike
 G 2044
 6-1-85

6-1 1985 Flycatcher Well Pike
 date well completed firm name county well located

LANDOWNER:	description of formations encountered	from	to
<u>Louy Temple</u>			
<u>R.R. Magnolia, ms.</u> (mailing address)	<u>Red Clay</u> <u>Red Sand</u> <u>Coarse sand & gravel</u>	<u>0</u> <u>20</u> <u>85</u>	<u>25</u> <u>85</u> <u>109</u>
WELL LOCATION:			
sec. <u>17</u> T <u>2</u> N R <u>7</u> E S W <u>5</u> miles <u>W</u> of <u>Magnolia</u> (distance) (direction) (nearest town)			
WELL PURPOSE: <u>Home</u> (home, irrigation, municipal, industrial)			
WELL COMPLETION DATA:			
(1) diameter (inches) <u>4</u>			
(2) total depth (feet) <u>109</u>			
(3) static water level (feet) <u>60</u> below above top of ground.			
(4) casing <u>PVC</u> , <u>99</u> (material) (depth) <u>4</u> (size) if telescope see back.			
(5) screen <u>10</u> , <u>99</u> (length) (depth to top)			
(6) pump <u>4</u> , <u>PVC</u> (size) (material)			
(6) pump <u>1/2</u> , <u>10</u> (HP) (yield gpm)			
<u>elec</u> (type power)			
(7) electric log <u>No</u> (yes or no)			
<u>(organization running log)</u>			
(8) how well bottom plugged <u>Sand fill</u>			
DRILLERS REMARKS:			

If well telescopes please sketch and show depths.

GROUND LEVEL

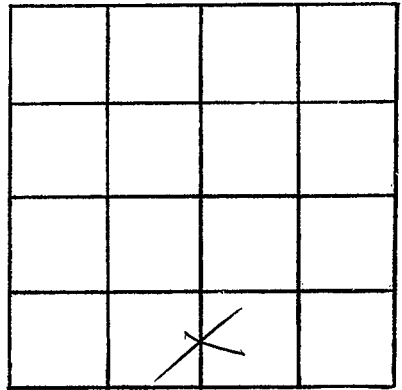

SECTION 17

Please indicate well location X.

ADDITIONAL INFORMATION

If more than one screen,
show locations of each on sketch.