

MISSISSIPPI DEPARTMENT OF NATURAL RESOURCES

Bureau of Land and Water Resources

Southport Mall

P.O. Box 10631

Jackson, Mississippi 39209

WATER WELL DRILLERS LOG

Pike
G
2045

3-7
date well completed

1986 Fitzgerald Well Serv
firm name

Pike
county well located

LANDOWNER:

Zeb Floyd

R.R. Mazonia, ms.
(mailing address)

description of formations encountered

from

to

Red clay
Red sand
Coarse sand & gravel

0 20
20 125
125 139

WELL LOCATION:

sec. 1 T. 2 N
SE 1/4; SW 1/4 S

R. 7 E
W

1 miles S of Fernwood
(distance) (direction) (nearest town)

WELL PURPOSE:

Home
(home, irrigation, municipal, industrial)

WELL COMPLETION DATA:

- (1) diameter (inches) 4
- (2) total depth (feet) 139
- (3) static water level (feet) 75 below above top of ground.
- (4) casing PVC, 129, (material), (depth),
4 (size) if telescope see back.
- (5) screen 10, 129 (length), (depth to top)
4 (size), PVC (material)
- (6) pump 1/2, 10 (HP), (yield gpm)
Elh (type power)
- (7) electric log No (yes or no)
(organization running log)
- (8) how well bottom plugged [Signature]

RECEIVED


MAR 13 1986

Department of Natural Resources
Bureau of Land & Water Resources

DRILLERS REMARKS:

If well telescopes please sketch and show depths.

GROUND LEVEL

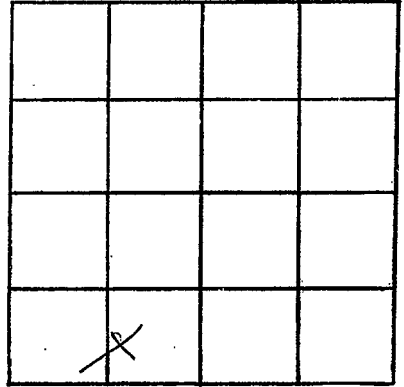

SECTION 1

Please indicate well location X.

ADDITIONAL INFORMATION

If more than one screen,
show locations of each on sketch.