

PIKE
G
2046

MISSISSIPPI DEPARTMENT OF NATURAL RESOURCES
Bureau of Land and Water Resources
Southport Mall
P.O. Box 10631
Jackson, Mississippi 39209
WATER WELL DRILLERS LOG

7-8 1986 El General Well Serv Pike
date well completed firm name county well located

LANDOWNER:
W.E. Garner
P.O. Magnolia Ms.
(mailing address)

| description of formations encountered | from | to |
|---------------------------------------|------|-----|
| Red clay | 0 | 20 |
| Coarse sand & gravel | 20 | 84 |
| white chalk | 84 | 118 |
| Coarse sand & gravel | 118 | 130 |

WELL LOCATION:
sec. 11 T 2 N R 7 E
S W
1/2 miles W of Magnolia
(distance) (direction) (nearest town)

WELL PURPOSE:
(home, irrigation, municipal, industrial)

- WELL COMPLETION DATA:
- (1) diameter (inches) 4
 - (2) total depth (feet) 130
 - (3) static water level (feet) 90 below above top of ground.
 - (4) casing PVC, 120,
(material) (depth)
4 if telescope see back.
(size)
 - (5) screen 10, 120
(length) (depth to top)
4, PVC
(size) (material)
 - (6) pump 1, 6
(HP) (yield gpm)
elec
(type power)
 - (7) electric log No
(yes or no)
(organization running log)
 - (8) how well bottom plugged hard plug


RECEIVED
JUL 21 1986

Department of Natural Resources
Bureau of Land & Water Resources

DRILLERS REMARKS:

If well telescopes please sketch and show depths.

GROUND LEVEL

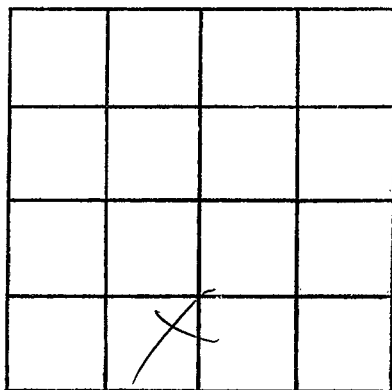

SECTION 11

Please indicate well location X.

ADDITIONAL INFORMATION

If more than one screen,
show locations of each on sketch.