

PIKE
G 2047

MISSISSIPPI DEPARTMENT OF NATURAL RESOURCES
Bureau of Land and Water Resources
Southport Mall
P.O. Box 10631
Jackson, Mississippi 39209
WATER WELL DRILLERS LOG

11-26 1986 date well completed
F. J. Smith well firm name
Pike county well located

LANDOWNER: C. L. Rejbar
R.R. Magnolia, Ms. (mailing address)

description of formations encountered	from	to
Red clay	0	20
Red sand	20	120
Coarse sand gravel	120	135

WELL LOCATION:
sec. 30 T 2 N R 2 E S W
5 miles SW of Magnolia (distance) (direction) (nearest town)

WELL PURPOSE: Home (home, irrigation, municipal, industrial)

- WELL COMPLETION DATA:
- (1) diameter (inches) 4
 - (2) total depth (feet) 135
 - (3) static water level (feet) 85 below top of ground.
 - (4) casing PVC, 125 (material), (depth)
4 (size) if telescope see back.
 - (5) screen 10 (length), 125 (depth to top)
4 (size), PVC (material)
 - (6) pump 1/2 (HP), 10 (yield gpm)
Elc (type power)
 - (7) electric log no (yes or no)
(organization running log)
 - (8) how well bottom plugged Seal plug


RECEIVED
DEC 22 1986

Department of Natural Resources
Bureau of Land & Water Resources

DRILLERS REMARKS:

If well telescopes please sketch and show depths.

GROUND LEVEL

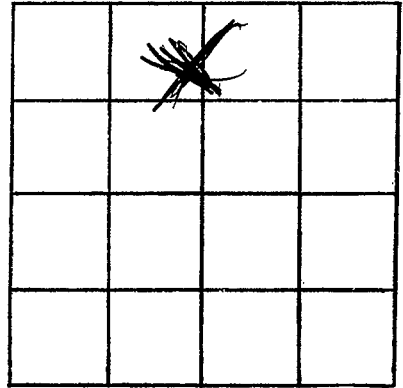

SECTION 30

Please indicate well location X.

ADDITIONAL INFORMATION

If more than one screen,
show locations of each on sketch.