

MISSISSIPPI DEPARTMENT OF NATURAL RESOURCES

Bureau of Land and Water Resources

P.O. Box 10631
Jackson, Mississippi 39209
WATER WELL DRILLERS LOG

COUNTY WELL LOCATED	
Pipe WELL NUMBER G	CODED
DATE WELL COMPLETED 2050 Sept 26- 88	

PERMIT NUMBER
NAME OF DRILLING FIRM FITZGERALD Well Serv

NAME & MAILING ADDRESS OF LANDOWNER			
Jim Harrington			
RR. 3, M'Comb, MS.			
WELL LOCATION:	SEC	TOWNSHIP	RANGE
	6	2 ^N _S	7 ^E _W
DISTANCE	DIRECTION	NEAREST TOWN	
2 Miles	SW	of Pecoy Queen	
OTHER LANDMARK			
WELL PURPOSE: Home, Irrigation, Municipal, Industrial, Fish Pond, etc.			
Home			

PUMP DATA		
PUMP TYPE (Circle One):		
<input checked="" type="radio"/> Submersible	<input type="radio"/> Turbine	<input type="radio"/> Jet
Other (Describe) _____		
POWER TYPE (Circle One):		
<input checked="" type="radio"/> Electric	<input type="radio"/> Tractor	<input type="radio"/> Diesel
<input type="radio"/> Gasoline	<input type="radio"/> Butane	
Other (Describe) _____		
Pump Capacity (GPM)	No. of Stages	Setting Depth
10	9	85 FT.
PUMP TEST		
Well yielded 10 GPM with		
a drawdown of 2 ft.		
after 2 hours of pumping		

WELL DATA		
Well Depth	Casing Diameter (In.)	Casing Length (Ft.)
108	4"	98
Type of Casing	Hole Depth	Depth to Static Water Level
PVC	108	58
TYPE OF COMPLETION: (Circle One or More):		
<input checked="" type="checkbox"/> Gravel Packed	<input type="checkbox"/> Underreamed	<input type="checkbox"/> Telescoped
<input type="checkbox"/> Natural Development	<input type="checkbox"/> Open Hole	<input type="checkbox"/> Other
Top of Lap Pipe or Reduction in Casing		
FEET	IF TELESCOPED OR MORE THAN ONE SCREEN: USE BACK PAGE	

LOG DATA	
TYPE OF LOG RUN (Circle One):	
<input type="radio"/> Electric	<input type="radio"/> Gamma Ray
<input type="radio"/> Density	<input type="radio"/> Sonic
<input type="radio"/> Other (Describe) _____	<input checked="" type="radio"/> No Log Run
Name of Organization Running Log	

SCREEN DATA		
Diameter - Inches	Length - Feet	Slot Size - Inches
4	10	10/4
Screen Type	Depth to Bottom - Feet	
PVC	108	

GEOLOGIC DATA (Office Use Only)			
Surface Elev.	Geologic Unit	Unit Thickness	Depth to Top
Subs. SWL	Date	Analysis	Aquifer Test
Driller's Remarks			


DESCRIPTION OF FORMATIONS ENCOUNTERED	FROM	TO
Real clay	0	20
Real sand	20	90
Coarse sand & gravel	90	108

FORMATIONS (Continued)	FROM	TO
RECEIVED		
OCT 13 1988		
Department of Natural Resources		
Bureau of Land & Water Resources		

IF MORE SPACE IS NEEDED, USE BACK

If well telescopes please
sketch and show depths.

GROUND LEVEL

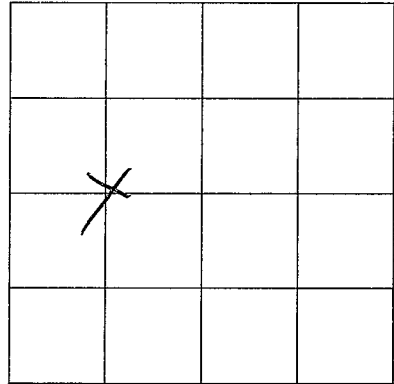

SECTION 6

Please indicate well location X.

ADDITIONAL INFORMATION

If more than one screen,
show location of each on sketch.