

7

MISSISSIPPI DEPARTMENT OF NATURAL RESOURCES

Bureau of Land and Water Resources

COUNTY WELL LOCATED
Pike

WELL NUMBER
G CODED

2051

DATE WELL COMPLETED
2-9-89

PERMIT NUMBER

NAME OF DRILLING FIRM
Fitzgerald Well Sew

P.O. Box 10631
Jackson, Mississippi 39209
WATER WELL DRILLERS LOG

NAME & MAILING ADDRESS OF LANDOWNER
Janus Reims -
R.R. Magnolia, Miss.

WELL LOCATION: SEC *23* TOWNSHIP *2* RANGE *7* *E* *W*

DISTANCE *1/2* Miles DIRECTION *S* NEAREST TOWN *of Magnolia*

OTHER LANDMARK

WELL PURPOSE: Home, Irrigation, Municipal, Industrial, Fish Pond, etc.
Home

PUMP DATA

PUMP TYPE (Circle One):
 Submersible, Turbine, Jet, Flowing Well, Other (Describe) _____

POWER TYPE (Circle One):
 Electric, Tractor, Diesel, Gasoline, Butane, Other (Describe) _____

Pump Capacity (GPM) *15* No. of Stages *12* Setting Depth *50* FT.

PUMP TEST

Well yielded *15* GPM with a drawdown of *3* ft. after *2* hours of pumping

WELL DATA

Well Depth <i>72</i>	Casing Diameter (In.) <i>4</i>	Casing Length (Ft.) <i>62</i>
Type of Casing <i>PVC</i>	Hole Depth <i>72</i>	Depth to Static Water Level <i>10</i>

TYPE OF COMPLETION: (Circle One or More):
 Gravel Packed, Underreamed, Telescoped, Natural Development, Open Hole, Other (Describe) _____

Top of Lap Pipe or Reduction in Casing

FEET IF TELESCOPED OR MORE THAN ONE SCREEN: USE BACK PAGE

LOG DATA

TYPE OF LOG RUN (Circle One):
 No Log Run, Electric, Gamma Ray, Density, Sonic, Neutron, Other (Describe) _____

Name of Organization Running Log

SCREEN DATA

Diameter - Inches <i>4</i>	Length - Feet <i>10</i>	Slot Size - Inches <i>1014</i>
Screen Type <i>PVC</i>	Depth to Bottom - Feet <i>72</i>	

GEOLOGIC DATA (Office Use Only)

Surface Elev.	Geologic Unit	Unit Thickness	Depth to Top
Subs. SWL	Date	Analysis	Aquifer Test

Driller's Remarks


RECEIVED

DESCRIPTION OF FORMATIONS ENCOUNTERED	FROM	TO	FORMATIONS (continued)	
			FROM	TO
<i>Red Clay</i>	<i>0</i>	<i>10</i>	<i>Department of Natural Resources</i>	<i>Resources</i>
<i>Red Sand</i>	<i>10</i>	<i>50</i>	<i>Bureau of Land & Water</i>	<i>Resources</i>
<i>Coarse Silt & gravel</i>	<i>50</i>	<i>72</i>		

IF MORE SPACE IS NEEDED, USE BACK

If well telescopes please
sketch and show depths.

GROUND LEVEL

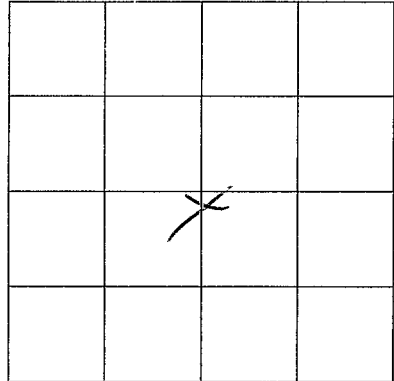

SECTION 23

Please indicate well location X.

ADDITIONAL INFORMATION

If more than one screen,
show location of each on sketch.