

MISSISSIPPI DEPARTMENT OF ENVIRONMENTAL QUALITY

Office of Land and Water Resources

P. O. Box 10631
Jackson, MS 39289-0631
WATER WELL DRILLERS LOG

COUNTY WELL LOCATED
Pike

WELL NUMBER
G 2065

DATE WELL COMPLETED
4-21-97

PERMIT NUMBER

NAME OF DRILLING FIRM
Fitzgerald Well

NAME & MAILING ADDRESS OF LANDOWNER
Pam Robins
RR Magnolia

WELL LOCATION: SEC 15 TOWNSHIP 2 N S RANGE 7 E W

DISTANCE 5 Miles DIRECTION W of NEAREST TOWN Magnolia

OTHER LANDMARK

WELL PURPOSE: Home Irrigation, Municipal, Industrial, Fish Pond, etc.

PUMP DATA

PUMP TYPE (Circle One): ~~Comersible~~ Turbine, Jet, Flowing Well, Other (Describe)

POWER TYPE (Circle One): Electric, Tractor, Diesel, Gasoline, Butane, Other (Describe) H/P

Pump Capacity (GPM) 12 No. of Stages 1 Setting Depth 30 FT.

PUMP TEST

Well yielded 50 GPM with a drawdown of 1 ft. after 1 hours of pumping

WELL DATA

Well Depth 33" Casing Diameter (In.) 4" Casing Length (Ft.) 13"

Type of Casing PVC Hole Depth 33" Depth to Static Water Level 6"

TYPE OF COMPLETION: (Circle One or More): Gravel Packed, Underreamed, Telescoped, Natural Development, Open Hole, Other

WELL GROUTED TO A DEPTH OF 10 FEET
Type Grout (circle one): Cement, Bentonite, Mix

LOG DATA

TYPE OF LOG RUN (Circle One): No Log Run, Electric, Gamma Ray, Density, Sonic, Neutron, Other (Describe)

Name of Organization Running Log

SCREEN DATA

Diameter - Inches 4" Length - Feet 20 Slot Size - Inches 0.12/0.10

Screen Type PVC Depth to Bottom - Feet 33"

GEOLOGIC DATA (Office Use Only)

Surface Elev.	Geologic Unit	Unit Thickness	Depth to Top
Subs. SWL	Date	Analysis	Aquifer Test

Driller's Remarks

Top of Lap Pipe or Reduction in Casing

FEET IF TELESCOPED OR MORE THAN ONE SCREEN: USE BACK PAGE

DESCRIPTION OF FORMATIONS ENCOUNTERED	FROM	TO	FORMATIONS (Continued)	FROM	TO
<u>Top Soil</u>	<u>0</u>	<u>5</u>			
<u>Sand & Gravel</u>	<u>5</u>	<u>33</u>			

RECEIVED


SEP 15 1997

Dept. of Environmental Quality
Office of Land & Water Resources

IF MORE SPACE IS NEEDED, USE BACK

If well telescopes please
sketch and show depths.

GROUND LEVEL

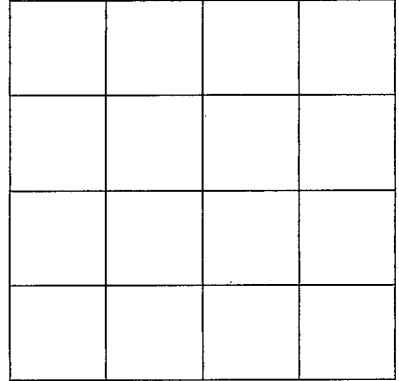

SECTION _____

Please indicate well location X.

ADDITIONAL INFORMATION

If more than one screen,
show location of each on sketch.