

MISSISSIPPI DEPARTMENT OF ENVIRONMENTAL QUALITY

Office of Land and Water Resources

P. O. Box 10631
Jackson, MS 39289-0631
WATER WELL DRILLERS LOG

COUNTY WELL LOCATED PIKE	
WELL NUMBER 2069	CODED
DATE WELL COMPLETED 7-30-97	

PERMIT NUMBER 0-287
NAME OF DRILLING FIRM REEVES WELL SER.

NAME & MAILING ADDRESS OF LANDOWNER THE WAREHOUSE			
WELL LOCATION: SEC 21 TOWNSHIP 2 RANGE 7			
DISTANCE 3 Miles DIRECTION W of NEAREST TOWN MAGNOLIA			
OTHER LANDMARK			
WELL PURPOSE: Home, Irrigation, Municipal, Industrial, Fish Pond, etc. CHICKEN FARM			

PUMP DATA		
PUMP TYPE (Circle One): Submersible, Turbine, Jet, Flowing Well, Other (Describe)		
POWER TYPE (Circle One): Electric, Tractor, Diesel, Gasoline, Butane, Other (Describe)		
Pump Capacity (GPM)	No. of Stages	Setting Depth
PUMP TEST		
Well yielded	50	GPM with
a drawdown of	0	ft.
after	1	hours of pumping

WELL DATA		
Well Depth 120'	Casing Diameter (In.) 4"	Casing Length (Ft.) 20'
Type of Casing PVC	Hole Depth 120'	Depth to Static Water Level 75'
TYPE OF COMPLETION: (Circle One or More): Gravel Packed, Underreamed, Telescoped, Natural Development, Open Hole, Other (Describe) 10 GAL. SAND		
WELL GROUTED TO A DEPTH OF 10 FEET Type Grout (circle one): Cement Bentonite, or Mix		

LOG DATA	
TYPE OF LOG RUN (Circle One): Electric, Gamma Ray, Density, Sonic, Neutron, Other (Describe) No Log Run	
Name of Organization Running Log	

SCREEN DATA		
Diameter - Inches 4"	Length - Feet 10'	Slot Size - Inches 10Thds.
Screen Type PVC	Depth to Bottom - Feet 120'	

GEOLOGIC DATA (Office Use Only)			
Surface Elev.	Geologic Unit	Unit Thickness	Depth to Top
Subs. SWL	Date	Analysis	Aquifer Test
Driller's Remarks			
Top of Lap Pipe or Reduction in Casing			
FEET		IF TELESCOPED OR MORE THAN ONE SCREEN: USE BACK PAGE	

DESCRIPTION OF FORMATIONS ENCOUNTERED	FROM	TO
CLAY	0	10
SAND & GRAVEL	10	70
CHALK	70	100
SAND & GRAVEL	100	120

FORMATIONS (Continued)	FROM	TO

RECEIVED


SEP 23 1997

Dept. of Environmental Quality
Office of Land & Water Resources

IF MORE SPACE IS NEEDED, USE BACK

If well telescopes please sketch and show depths.

GROUND LEVEL

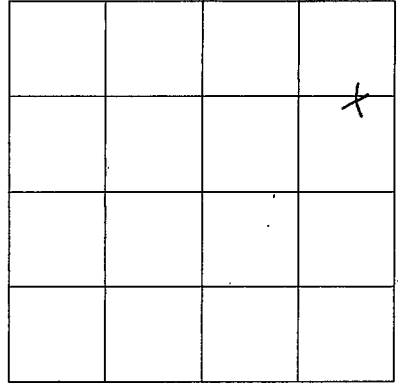

SECTION 21

Please indicate well location X.

ADDITIONAL INFORMATION

Lined area for additional information.

If more than one screen, show location of each on sketch.