

MISSISSIPPI DEPARTMENT OF ENVIRONMENTAL QUALITY

Office of Land and Water Resources

P. O. Box 10631
Jackson, MS 39289-0631
WATER WELL DRILLERS LOG

COUNTY, WELL LOCATED
Vike.

WELL NUMBER _____ CODED _____

G 2076

DATE WELL COMPLETED
3-6-00

PERMIT NUMBER _____

NAME OF DRILLING FIRM
Fitzgerald Well Service.

NAME & MAILING ADDRESS OF LANDOWNER
Roy CeFalu
church Rd. Magnolia, MS.

WELL LOCATION: SEC 30 TOWNSHIP 2 RANGE 7
N W
S E

DISTANCE 7 Miles DIRECTION NW of NEAREST TOWN Osyka

OTHER LANDMARK _____

WELL PURPOSE Home Irrigation, Municipal, Industrial, Fish Pond, etc.

PUMP DATA

PUMP TYPE (Circle One):
Submersible, Turbine, Jet, Flowing Well,
Other (Describe) _____

POWER TYPE (Circle One):
Electric, Tractor, Diesel, Gasoline, Butane,
Other (Describe) _____ H/P 12

Pump Capacity (GPM) 12 No. of Stages 9 Setting Depth 100' FT.

PUMP TEST

Well yielded _____ GPM with
a drawdown of _____ ft.
after _____ hours of pumping

WELL DATA

Well Depth 109 Casing Diameter (In.) 4" Casing Length (Ft.) 99'

Type of Casing PVC Hole Depth 109- Depth to Static Water Level 71'

TYPE OF COMPLETION: (Circle One or More):
Gravel Packed, Underreamed, Telescoped,
Natural Development, Open-Hole, Other
(Describe) _____

WELL GROUTED TO A DEPTH OF 10 FEET
Type Grout (circle one): Cement, Bentonite, of Mix

LOG DATA

TYPE OF LOG RUN (Circle One):
No Log Run, Electric, Gamma Ray, Density, Sonic, Neutron,
Other (Describe) _____

Name of Organization Running Log _____

SCREEN DATA

Diameter - Inches 4" Length - Feet 10 Slot Size - Inches .012

Screen Type PVC Depth to Bottom - Feet 109'

GEOLOGIC DATA (Office Use Only)

Surface Elev.	Geologic Unit	Unit Thickness	Depth to Top
Subs. SWL	Date	Analysis	Aquifer Test

Driller's Remarks _____

Top of Lap Pipe or Reduction in Casing _____

FEET IF TELESCOPED OR MORE THAN ONE SCREEN; USE BACK PAGE


DESCRIPTION OF FORMATIONS ENCOUNTERED	FROM	TO	FORMATIONS (Continued)	FROM	TO
<u>Clay</u>	<u>0</u>	<u>30</u>			
<u>Sand</u>	<u>30</u>	<u>80</u>			
<u>Clay</u>	<u>80</u>	<u>90</u>			
<u>coarse sand & gravel</u>	<u>90</u>	<u>110</u>			

REC'D JUN 21 2001

IF MORE SPACE IS NEEDED, USE BACK

If well telescopes please sketch and show depths.

GROUND LEVEL

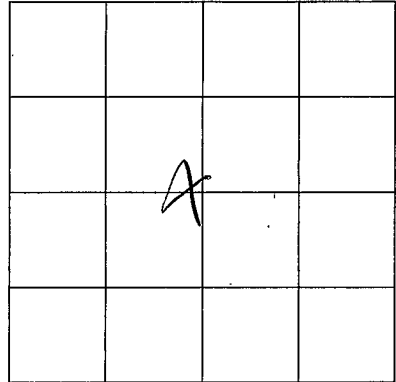

SECTION 30

Please indicate well location X.

ADDITIONAL INFORMATION

If more than one screen,
show location of each on sketch.