

Pike
H
2-68

MISSISSIPPI
BOARD OF WATER COMMISSIONERS
416 North State Street
Jackson, Mississippi 39201

WATER WELL DRILLERS LOG

Feb 9 1968 Fitzgerald Well Dr Pike
date well completed firm name county well located

LANDOWNER: Morris Smith

description of formations encountered from to

RR
Magnolia Miss.
(mailing address)

Red clay	0	15
Red sand	15	45
Coarse sand & gravel	45	80
Red gravel	80	96
White chalk	96	120
Blue chalk	120	125
Red sand	125	140
Coarse sand	140	146
Coarse sand & gravel	146	154


WELL LOCATION:
sec. 33 T 2 N R. 8 E
5 miles SE of Magnolia
(distance) (direction) (nearest town)

WELL PURPOSE: Home
(home, irrigation, municipal, industrial)

WELL COMPLETION DATA:


- (1) diameter (inches) 4
- (2) total depth (feet) 154
- (3) static water level (feet) 90 below above top of ground.
- (4) casing Plastic, 148,
(material) (depth)
4 if telescope see back.
(size)
- (5) screen 6', 148
(length) (depth to top)
4", plastic
(size) (material)
- (6) pump 3, 3
(HP) (yield gpm)
Electric
(type power)
- (7) electric log No
(yes or no)
(organization running log)
- (8) how well bottom plugged Steel plug

DRILLERS REMARKS:

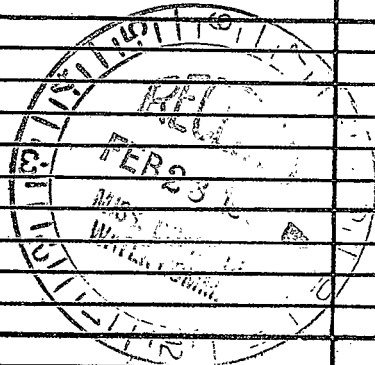

If well telescopes please sketch and show depths.

GROUND LEVEL

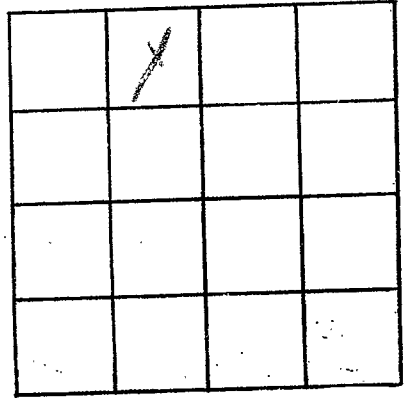

SECTION 33

Please indicate well location X.

ADDITIONAL INFORMATION

If more than one screen, show locations of each on sketch.