

PIKE  
H  
10/5/79

MISSISSIPPI  
BOARD OF WATER COMMISSIONERS  
416 North State Street  
Jackson, Mississippi 39201

CODED

WATER WELL DRILLERS LOG

Oct 5 1979 Cheater Reames Pikes  
date well completed firm name county well located

LANDOWNER: James E. Hall  
Rt 1, Magnolia

description of formations encountered	from	to
clay	0	20
Red Sand	20	37
Sand & gravel	37	98
Sand & chalk	98	100
white chalk	100	135
Red Sand	135	146

(mailing address)

WELL LOCATION:

sec 9 T 2 N R 8 E  
3 miles E of Magnolia  
(distance) (direction) (nearest town)

WELL PURPOSE: house  
(home, irrigation, municipal, industrial)


WELL COMPLETION DATA:

- (1) diameter (inches) 4"
- (2) total depth (feet) 146
- (3) static water level (feet) 96 below above top of ground.
- (4) casing Plast Ballam  
(material) (depth)
- (size) If telescope see back.
- (5) screen 6' 100  
(length) (depth, to top)
- 4" Plast  
(size) (material)
- (6) pump 1/2 Jet 6  
(HP) (yield gpm)
- elect  
(type power)
- (7) electric log NO  
(yes or no)

(organization running log)

(8) how well bottom plugged  
wood plug


DRILLERS REMARKS:  
new house.

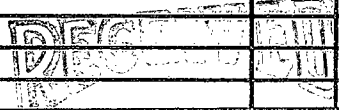

NOV 18 1979

If well telescopes please sketch and show depths.

GROUND LEVEL

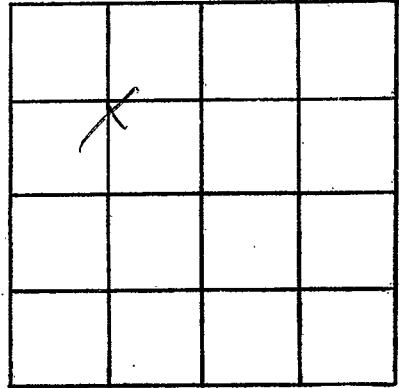

SECTION 9

Please indicate well location X.

ADDITIONAL INFORMATION

If more than one screen,  
show locations of each on sketch.