

Pike Co
~~H~~
 3-20-70

MISSISSIPPI
 BOARD OF WATER COMMISSIONERS
 416 North State Street
 Jackson, Mississippi 39201

WATER WELL DRILLERS LOG

CODED

WALTHALL

3-20 1970 date well completed
 Fitzgerald well firm name
 county well located

LANDOWNER:
 St. Joseph Church
 RR Magnolia, Miss.
 (mailing address)

description of formations encountered	from	to
Red clay	0	45
Red sand	45	65
Gravel	65	120
fine white sand	120	135
hard gravel	135	152

WELL LOCATION:
 sec. 1 T. 1 N. R. 9 E. M.
 9 miles WSW of Tylertown
 (distance) (direction) (nearest town)

WELL PURPOSE: Home
 (home, irrigation, municipal, industrial)

- WELL COMPLETION DATA:
- diameter (inches) 4
 - total depth (feet) 152
 - static water level (feet) 100 below top of ground.
 - casing Plastic, 144 (material) (depth)
 4 (size) if telescope see back.
 - screen 6, 144 (length) (depth to top)
 4 (size) Plastic (material)
 - pump 1/2, 8 (HP) (yield gpm)
 (type power)
 - electric log No (yes or no)
 (organization running log)
 - how well bottom plugged wooden

CODED


APR 6 1970

MISS. BD. OF
 WATER COMM.

DRILLERS REMARKS:

If well telescopes please sketch and show depths.

GROUND LEVEL

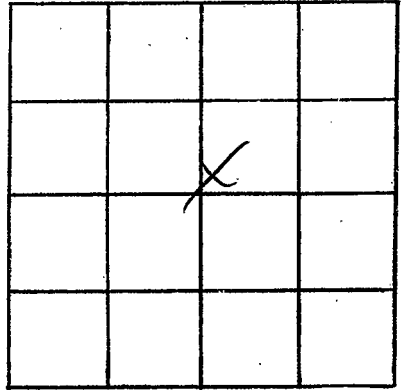

SECTION 1

Please indicate well location X.

ADDITIONAL INFORMATION

If more than one screen, show locations of each on sketch.