

PIKE  
H  
8-29-74

MISSISSIPPI  
BOARD OF WATER COMMISSIONERS  
416 North State Street  
Jackson, Mississippi 39201

CODED

WATER WELL DRILLERS LOG

Aug 29 1974 date well completed  
Chester Reeves firm name  
Pike county well located

LANDOWNER: Bapt Church  
Rt. Magnolia  
(mailing address)

description of formations encountered	from	to
Sandy clay	0	12
clay gravel	12	26
Sand gravel gravel	26	60

WELL LOCATION:  
sec 26 T 2 N R 5 E  
6 miles SE of Magnolia  
(distance) (direction) (nearest town)

WELL PURPOSE: Home - Church  
(home, irrigation, municipal, industrial)


- WELL COMPLETION DATA:
- (1) diameter (inches) 4"
  - (2) total depth (feet) 60
  - (3) static water level (feet) 22 below top of ground.
  - (4) casing Best Ballam  
(material) (depth)
  - \_\_\_\_\_ if telescope see back.  
(size)
  - (5) screen 6' 5'  
(length) (depth to top)
  - 4" plastic  
(size) (material)
  - (6) pump old jet pump  
(HP) (yield gpm)
  - sleat  
(type power)
  - (7) electric log no  
(yes or no)
  - \_\_\_\_\_ (organization running log)
  - (8) how well bottom plugged wood chips

DRILLERS REMARKS:  
old 2" well bad

DECEMBER 1974  
OCT 01 1974

If well telescopes please sketch and show depths.

GROUND LEVEL

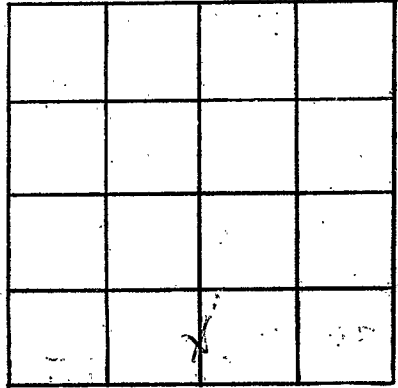

SECTION 26

Please indicate well location X.

ADDITIONAL INFORMATION

If more than one screen,  
show locations of each on sketch.