

PIKE HI

10-5-61 CODED

WATER WELL DRILLERS LOG

H

Date: 10-5, 1961, Driller: Chester Reeves County Pike

(Name)

(1) Owner of Land:	Description & Color of Materials Sand, Clay, Red Clay, Shell, etc.	Thick- ness Feet
Rev. John Hemphill (Name)	Red clay	20
RFD1, Magnolia (Address)	Red sand	25
(2) Location: 1/4, 1/4, Sec. 22 T. 28 R. 8	Yellow soupy sand	40
2 miles EAST of Magnolia (distance) (direction) (Nearest Town)	Coarse sand & small gravel	5
(3) Topography: Hilly (Hilly) (Flat) (Level)		90
(4) Purpose of Well: Domestic (Domestic Irrigation Municipal, Industrial, Other)		

Information upon completion of well:


- (1) Diameter 4 inches.
- (2) Total Depth 90 feet.
- (3) Water Level 60 feet below top of ground.
- (4) Cased to Bottom Size 4"
- (5) Screen: Size None Length
- (6) Were any formations sealed against pollution?
yes, no.

If YES depth of formation

Why

Drillers Remarks: new house
no previous well

CODED

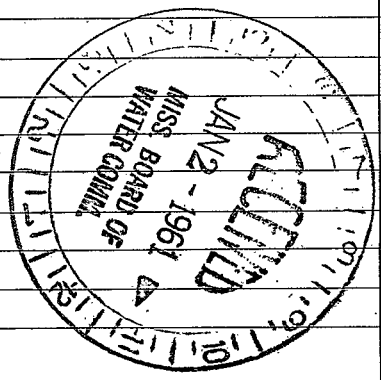

(Use Back Side)

1890
1891
1892

1916