

PIKE
H5

600

MISSISSIPPI BOARD OF WATER COMMISSIONERS

12-17-65

WATER WELL DRILLERS LOG

Date: 12-17, 1965, Driller: Chester Reeves County Pike
(Name)

(1) Owner of Land: Mrs. T.W. Durham
(Name)
Rt-1, Magnolia
(Address)

(2) Location: 1/4, 1/4, Sec. 10 T2R2
5 miles N.E. of Magnolia
(distance) (direction) (Nearest Town)

(3) Topography: Hilly
(Hilly) (Flat) (Level)

(4) Purpose of Well: Domestic
(Domestic Irrigation
Municipal, Industrial, Other)

Description & Color of Materials Sand, Clay, Red Clay, Shell, etc.	Thick- ness Feet	Depth Feet
Tuff clay	20	20
Red & pink chalk	30	50
Sandstone	40	90
gravel & clay sand	30	120

Information upon completion of well:

(1) Diameter 4 inches.

(2) Total Depth 120 feet.


(3) Water Level 28 feet below top of ground.

(4) Cased to Bottom Size 4"

(5) Screen: Size 4", Length 6'

(6) Were any formations sealed against pollution?
yes, no.

CODED

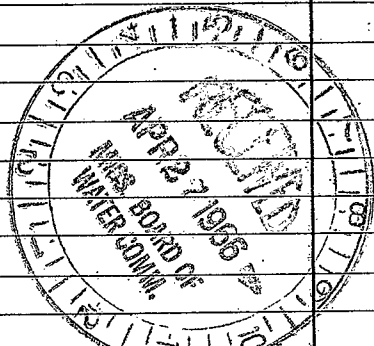

If YES depth of formation _____

Why _____

Drillers Remarks: red well
went bad.

REEVES WELL & PUMP CO.
P. O. BOX 71 -- PHONE 684-1451
McCOMB, MISS.

(Use Back Side)

Well No.

