

Pike
 H T **CODED**
 9-66

MISSISSIPPI
 BOARD OF WATER COMMISSIONERS
 416 North State Street
 Jackson, Mississippi 39201

WATER WELL DRILLERS LOG

9-5 1966 Fitzgerald Water Well Service Pike
 date well completed firm name county well located

LANDOWNER: Jack Simmons

Magnolia, RT MISS
 (mailing address)

WELL LOCATION:
 sec 22 T 2 N 8 E
8 miles E of Magnolia
 (distance) (direction) (nearest town)


WELL PURPOSE: home
 (home, irrigation, municipal, industrial)

WELL COMPLETION DATA:

- (1) diameter (inches) 4
- (2) total depth (feet) 133
- (3) static water level (feet) 75 below above top of ground.
- (4) casing ~~4"~~ 4" (material) plastic (depth) 75
- 4 (size) If telescope see back.
- (5) screen 8' (length) 75 (depth to top)
- 4" (size) plastic (material)
- (6) pump 1/2 set (HP) 5 (yield gpm)
- Elec (type power)
- (7) electric log no (yes or no)
- (organization running log)
- (8) how well bottom plugged Wood peg

description of formations encountered	from	to
Red clay	0	15
Sand	25	40
gravel	15	55
Chalky	10	65
gravel & sand	20	85
White Chalk		85


CODED

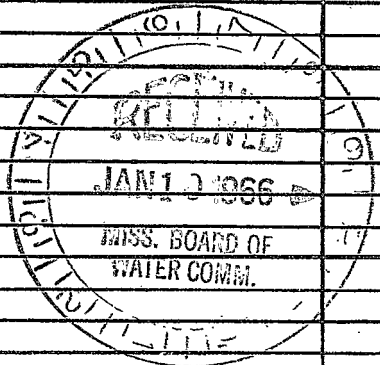

DRILLERS REMARKS:

If well telescopes please sketch and show depths.

GROUND LEVEL

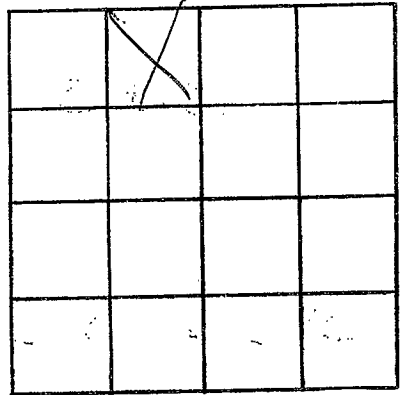

SECTION 22

Please indicate well location X.

ADDITIONAL INFORMATION

If more than one screen, show locations of each on sketch.