

Pike
H10
1-67

MISSISSIPPI
BOARD OF WATER COMMISSIONERS
416 North State Street
Jackson, Mississippi 39201

WATER WELL DRILLERS LOG

JAN 17 1967 REEVES WELL & PUMP PIKE
date well completed firm name county well located

LANDOWNER: mance
RAVENCROFT -
Rt-1, Magnolia -
(mailing address)

description of formations encountered	from	to
red Red clay	0	18
red sand	18	65
chalky gravel	65	90
lean gravel	90	107

WELL LOCATION:
sec. 18 T. 2 N. R. 8 E
3 miles NE of Magnolia
(distance) (direction) (nearest town)

WELL PURPOSE: Domestic
(home, irrigation, municipal, industrial)

WELL COMPLETION DATA:

- (1) diameter (inches) 4"
- (2) total depth (feet) 107
- (3) static water level (feet) 45 below top of ground.
- (4) casing Plastic Bottom
(material) (depth)
- 4 (size) if telescope see back.
- (5) screen 6' 101'
(length) (depth to top)
- 4" Plastic
(size) (material)
- (6) pump 3/4 HP 10
(HP) (yield gpm)
- Electric
(type power)
- (7) electric log no
(yes or no)

CODED

(organization running log)


(8) how well bottom plugged waddy

DRILLERS REMARKS: off well pad



If well telescopes please sketch and show depths.

GROUND LEVEL

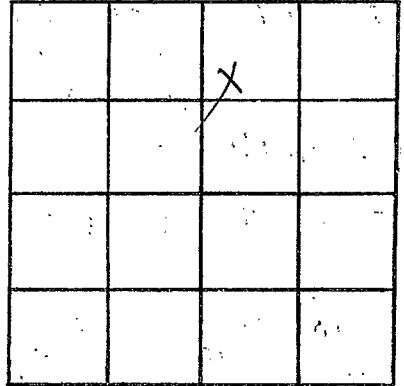

SECTION 18

Please indicate well location X.

ADDITIONAL INFORMATION

If more than one screen, show locations of each on sketch.