

Pike
 Hill **CODED**
 2-67

MISSISSIPPI
 BOARD OF WATER COMMISSIONERS
 416 North State Street
 Jackson, Mississippi 39201

WATER WELL DRILLERS LOG

Feb 15 1967 REEVES WELL & Pump Pike
 date well completed firm name county well located

LANDOWNER: Norma Hodge
RFD 1
McComb
 (mailing address)

description of formations encountered	from	to
Red clay	0	17
Red sand & gravel	17	45
Red chalky sand	45	68
Small gravel & sand	68	95
Red chalk & sand	95	117

WELL LOCATION:
 sec. 4 T. 2 N. R. 8 E
3 miles E of Ferrow
 (distance) (direction) (nearest town)

WELL PURPOSE: Home
 (home, irrigation, municipal, industrial)

WELL COMPLETION DATA:

- (1) diameter (inches) 4"
- (2) total depth (feet) 117
- (3) static water level (feet) 80 below top of ground.
- (4) casing Plastic Bottom
 (material) (depth)
4 (size) if telescope see back.
- (5) screen 6' 111'
 (length) (depth to top)
4" Plastic
 (size) (material)
- (6) pump None waired
 (HP) (yield/gpm) 20
 (type power)
- (7) electric log NO
 (yes or no)
 (organization running log)
- (8) how well bottom plugged waired


DRILLERS REMARKS:



CODED

If well telescopes please sketch and show depths.

GROUND LEVEL

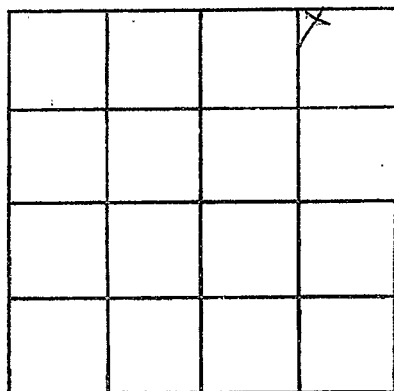

SECTION 4

Please indicate well location X.

ADDITIONAL INFORMATION

If more than one screen, show locations of each on sketch.