

**MISSISSIPPI
BOARD OF WATER COMMISSIONERS**
416 North State Street
Jackson, Mississippi 39201

WATER WELL DRILLERS LOG

Pike
H12
9-67

CODED

Sept 18 19*67* *Fitzgerald Well Service* *Pike*
date well completed firm name county well located

LANDOWNER: *H. Simmons*

description of formations encountered	from	to

RR. *Magnum Miss.*
(mailing address)

<i>Red clay</i>	<i>0</i>	<i>20</i>
<i>Coarse sand & gravel</i>	<i>20</i>	<i>72</i>

WELL LOCATION:
sec. *26T 2N* R. *8E*
8 miles *SE* of *Magnum*
(distance) (direction) (nearest town)

WELL PURPOSE: *Home*
(home, irrigation, municipal, industrial)

WELL COMPLETION DATA:

- (1) diameter (inches) *4*
- (2) total depth (feet) *72*
- (3) static water level (feet) *57* below above top of ground.
- (4) casing *Plastic, 66,*
(material) (depth)
4
(size) If telescope see back.
- (5) screen *6', 66'*
(length) (depth to top)
4"
(size) *Plastic*
(material)
- (6) pump *1* *6*
(HP) (yield gpm)
Electric
(type power)
- (7) electric log *No*
(yes or no)

CODED

(organization running log)


(8) how well bottom plugged *wood plug*

DRILLERS REMARKS:



If well telescopes please sketch and show depths.

GROUND LEVEL

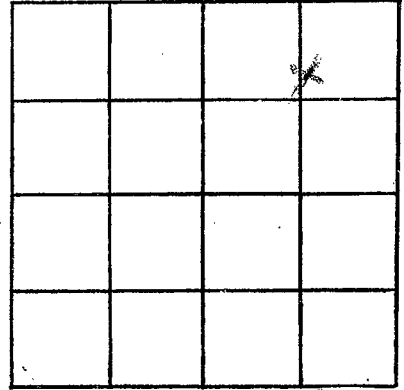

26

SECTION _____

Please indicate well location X.

ADDITIONAL INFORMATION

If more than one screen, show locations of each on sketch.