

CODED

MISSISSIPPI  
BOARD OF WATER COMMISSIONERS  
416 North State Street  
Jackson, Mississippi 39201

WATER WELL DRILLERS LOG

Pike  
H15  
10-67

Oct 4 1967 Reese Well Drilling Co. Pike  
date well completed firm name county well located

LANDOWNER: Robert James  
Rescott  
RFD Magnolia  
(mailing address)

description of formations encountered	from	to
<u>Red clay &amp; gravel</u>	<u>0</u>	<u>25</u>
<u>Red sand</u>	<u>25</u>	<u>55</u>
<u>gravel &amp; sand</u>	<u>9.5</u>	<u>105</u>

WELL LOCATION:  
sec. 19 T. 2 N R. 8 E  
2 1/2 miles SE of Magnolia  
(distance) (direction) (nearest town)

WELL PURPOSE: Home  
(home, irrigation, municipal, industrial)

WELL COMPLETION DATA:  
(1) diameter (inches) 4"  
(2) total depth (feet) 105  
(3) static water level (feet) 54 below above top of ground  
(4) casing Plastic bottom  
(material) (depth)

\_\_\_\_\_ if telescope see back.  
(size)  
(5) screen 6' 99'  
(length) (depth) to top  
4" Plastic  
(size) (material)


(6) pump 1/2 120  
(HP) (yield gpm)  
elect  
(type power)

(7) electric log No  
(yes or no)  
\_\_\_\_\_  
(organization running log)

(8) how well bottom plugged  
wooden plug


DRILLERS REMARKS:  
old well had

CODED

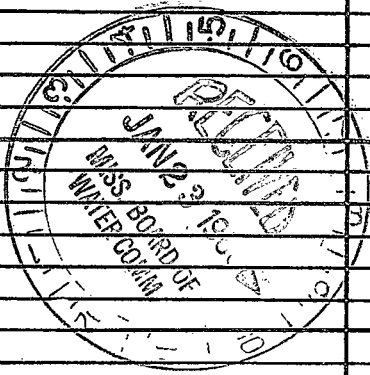

If well telescopes please sketch and show depths.

GROUND LEVEL

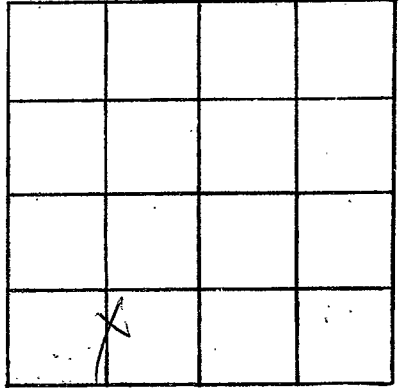

SECTION 19

Please indicate well location X.

ADDITIONAL INFORMATION

Lined area for additional information.

If more than one screen, show locations of each on sketch.