

Pike
 H 16 CODED
 1-68

MISSISSIPPI
 BOARD OF WATER COMMISSIONERS
 416 North State Street
 Jackson, Mississippi 39201

WATER WELL DRILLERS LOG

1-15 date well completed
 1968 Fitzgerald Water Well firm name
 Pike county well located

LANDOWNER: Scott Sauls

description of formations encountered

from to

RA Magnolia

Topsoil + Clay
 Red Sand
 gravel - Heavy
 Sand + gravel
 Sand
 peegravel

0 30
 30 68
 68 80
 80 100
 100 120
 120 128

(mailing address)

WELL LOCATION:


sec. 3 T. 2 N. R. 8 E.
 S W
 @ 4 miles E of Magnolia
 (distance) (direction) (nearest town)

WELL PURPOSE: home
 (home, irrigation, municipal, industrial)

WELL COMPLETION DATA:

- (1) diameter (inches) 4
- (2) total depth (feet) 128
- (3) static water level (feet) 95 below top of ground.
- (4) casing plastic 122 (material) (depth)
 4 (size) if telescope see back.
- (5) screen 6" 122 (length) (depth to top)
 4 (size) plastic (material)
- (6) pump 1 1/2 HP 10 gpm (HP) (yield gpm)
 3 hp (type power)
- (7) electric log no (yes or no)
 (organization running log)
- (8) how well bottom plugged


CODED

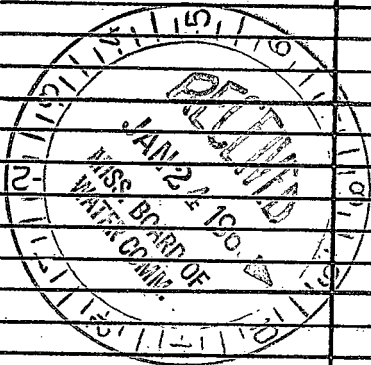

DRILLERS REMARKS:

If well telescopes please sketch and show depths.

GROUND LEVEL

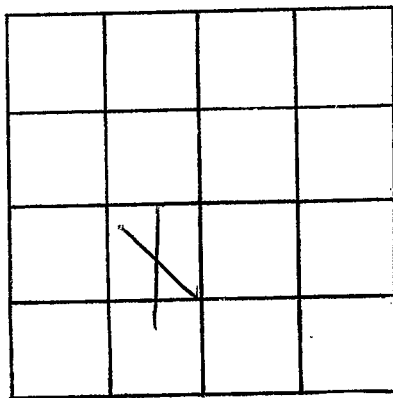

SECTION

3

Please indicate well location X.

ADDITIONAL INFORMATION

If more than one screen, show locations of each on sketch.