

Pike  
H17  
1-68

MISSISSIPPI  
BOARD OF WATER COMMISSIONERS  
416 North State Street  
Jackson, Mississippi 39201

WATER WELL DRILLERS LOG

Jan 9 1968 Remuswell Drilling Co. PIKE  
 (date well completed) (firm name) (county well located)

LANDOWNER: Lucile Pressall  
RFD 4  
Maple  
 (mailing address)

description of formations encountered	from	to
Red sandy clay	0	15
Red chalk	15	30
Red sand and small gravel	30	80
Pink chalk	80	85
Small gravel sand	85	99

WELL LOCATION:  
 sec. 19 T 2 N R 4 E  
2 1/2 miles SE of Maple  
 (distance) (direction) (nearest town)


WELL PURPOSE: Home  
 (home, irrigation, municipal, industrial)

WELL COMPLETION DATA:

- (1) diameter (inches) 4"
- (2) total depth (feet) 99
- (3) static water level (feet) 75 below top of ground
- (4) casing Plastic Bottom  
 (material) (depth)
- (size) if telescope see back.
- (5) screen 6" 93'  
 (length) (depth to top)
- 4" Plastic  
 (size) (material)
- (6) pump 1/2 HP - 1 1/2  
 (HP) (yield gpm)
- Plastic  
 (type power)
- (7) electric log NO-  
 (yes or no)
- (organization running log)

(8) how well bottom plugged  
wooden plug


DRILLERS REMARKS:  
Old well  
Dr.

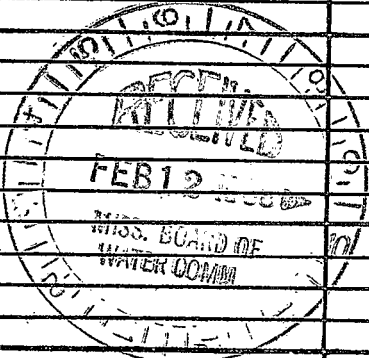

CODED

If well telescopes please sketch and show depths.

GROUND LEVEL

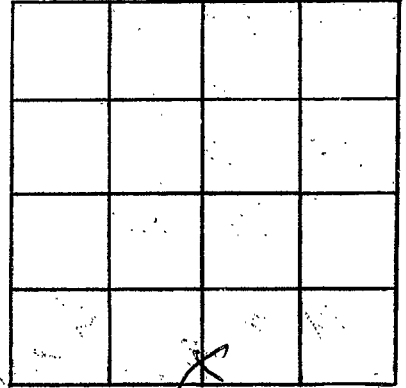

SECTION 19

Please indicate well location X.

ADDITIONAL INFORMATION

If more than one screen, show locations of each on sketch.