

PIKE
H21

MISSISSIPPI BOARD OF WATER COMMISSIONERS

3-5-64

WATER WELL DRILLERS LOG **CODED**

Date: 3-5, 1964, Driller: Chester Reeves County Pike
(Name)

(1) Owner of Land: <u>George Stagner</u> (Name) <u>RFD 1, Magnolia</u> (Address)	Description & Color of Materials Sand, Clay, Red Clay, Shell, etc.	Thick- ness Feet	Dep- th Feet
(2) Location: <u>1/4</u> , <u>15</u> <u>1/4</u> , Sec. <u>16</u> T <u>28</u> <u>5</u> miles <u>East</u> , of <u>Magnolia</u> (distance) (direction) (Nearest Town)	<u>clay</u> <u>Red Sand</u> <u>Sand & gravel</u>	<u>20</u> <u>50</u> <u>16</u>	<u>20</u> <u>70</u> <u>86</u>
(3) Topography: <u>Hilly</u> (Hilly) (Flat) (Level)			
(4) Purpose of Well: <u>Domestic</u> (Domestic Irrigation Municipal, Industrial, Other)			

Information upon completion of well:


- (1) Diameter 2 inches.
- (2) Total Depth 86 feet.
- (3) Water Level 60 feet below top of ground.
- (4) Cased to Bottom, Size 2"
- (5) Screen: Size 1/4", Length 6'
- (6) Were any formations sealed against pollution?
_____ yes, no.

If YES depth of formation _____

Why _____

Drillers Remarks: old well
sanded

CODED

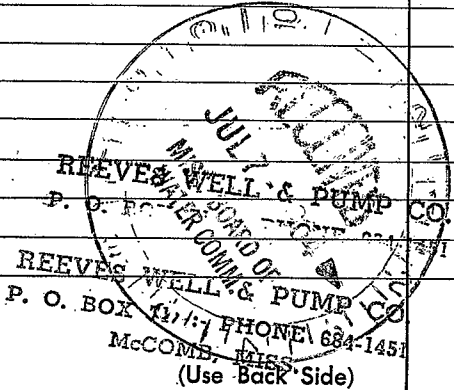

Well No. _____

