

PIKE
H 22
4-68

MISSISSIPPI
BOARD OF WATER COMMISSIONERS
416 North State Street
Jackson, Mississippi 39201

WATER WELL DRILLERS LOG

April 23 1968 28 Fitzgerald Water Well pike
date well completed firm name county well located

LANDOWNER: Wes Brumfield
Rt 4 Magnolia CV 803 MS
(mailing address)

description of formations encountered	from	to
Red gravel	0	20
Red Sand	20	30
Red Char	30	44
Gravel & sand	44	100

WELL LOCATION:
sec 25 T 2 N 8 E
S W
4 miles So Magnolia
(distance) (direction) (nearest town)

WELL PURPOSE: home
(home, irrigation, municipal, industrial)

- WELL COMPLETION DATA:
- (1) diameter (inches) 4
 - (2) total depth (feet) 99
 - (3) static water level (feet) 10 below top of ground.
 - (4) casing plastic 93-
(material) (depth)
 - 4 if telescope see back.
(size)
 - (5) screen 6' 93'
(length) (depth to top)
 - 4 plastic schro
(size) (material)
 - (6) pump 1 set 10-
(HP) (yield gpm)
 - elec
(type power)
 - (7) electric log no
(yes or no)
 - (organization running log)
 - (8) how well bottom plugged Wood peg

COPY


MAY 14 1968

DRILLERS REMARKS:

MISSISSIPPI
BOARD OF WATER COMMISSIONERS

If well telescopes please sketch and show depths.

GROUND LEVEL

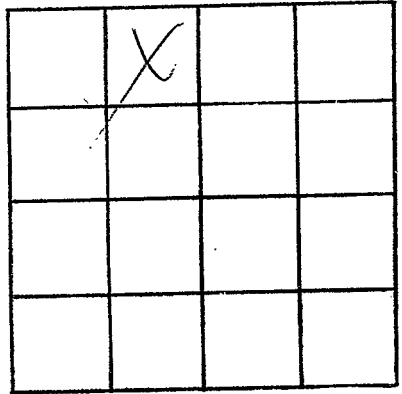

SECTION 25

Please indicate well location X.

ADDITIONAL INFORMATION

If more than one screen, show locations of each on sketch.